N 87"-44"-15" E 2 1/2" BRASS CAP SET ON A 66,87 11/4" X 30" GALVANIZED PIPE. PORCHES FOR 1989 UNITS #17 8 #21 POB CONCRETE 21:2019:18 LS 1815 P/2 (L,C,E,'s) (L,C,E) STAIRS S 86*-18'-56" E NOTE (): 8.5 FEET WIDE PARKING SPACES EXCEED CITY STANDARDS. # 20 8.5. ILCE #19 N 87"-39'-22" E BASIS of BEARING: LAND SURVEYOR CITY DATUM - 등 18.0 - 등을 #17 Sas a Dangle 18.0 (L.C.E.) STAIRS ROY O GAYLORD s 87°-44'-15 W 12/20/1989 1/1/ PLATTED 17 16 15 AS PER LAUNDRY CONCRETE PHASE ! 18,0 EASEMENT DESCRIPTION N 88*-52'-42" W 113,99 BEGNNING AT THE NORTHWEST CORNER OF PHASE I, THE LODGE AT HOOD RIVER" AS PLATTED. THENCE SOUTH I' II 47" WEST A DISTANCE OF 19.51 FEET, THENCE SOUTH 88 52 42" EAST A DISTANCE OF 113.99 FEET TO A RAILROAD SPIKE SET IN ASPHALT; THENCE NORTH 2º 15' 45" EAST A DISTANCE OF 26.20 FEET TO THE NORTH LINE OF SAID "PHASE I" SCALE THENCE SOUTH 87° 44' 15" WEST ALONG SAID NORTH LINE A DISTANCE OF 112,60 FEET TO THE POINT OF BEGINNING.

REFERENCES:

¢ COLUMBIA ST.

PRIOR TERRA BLOCK 3 BOUNDARY SURVEY OF 1988 AND PHASE ONE CONDOMINUM PLAT OF 1989.

NARRATIVE:

FOUND NO MAJOR DESCREPANCIES AND LOCATED ALL MONUMENTS OF RECORD.

> PHASE 2 THE LODGE AT HOOD RIVER, A CONDOMINIUM

BEING ALL A PART OF BLOCK 3, WAUCOMA ADDITION TO THE CITY OF HOOD RIVER. COUNTY OF HOOD RIVER. STATE OF OREGON.

FEB 2, 1990 Richard g Arrold

LEGEND:

SET MONUMENT AS NOTED SET 5/8" IRON ROD W/ CAP CALCULATED NOT FOUND OR SET O FOUND MONUMENT OF RECORD SET R/R SPIKE WITH X PK SET PK NAIL IN ASPHALT

I HEREBY CERTIFY THAT THIS SHEET I AND

SHEETS 2 AND 3 ARE A TRUE AND CORRECT

COPY OF THE ORIGINAL PLAT OF THE LODGE AT

HOOD RIVER, PHASE 2. ROY GAYLORD, PLS 1815 REVISED: JANUARY 24, 1990

RECORDING OFFICER

COMMON ELEMENTS

THE GENERAL COMMON ELEMENTS CONSIST OF THE FOLLOWING, TO THE EXTENT THEY EXIST ON THE PROPERTY, AND EXCEPT AS PORTIONS THEREOF ARE EXPRESSLY DESIGNATED IN THIS DECLAR-ATION AS PART OF A UNIT OR LIMITED COMMON ELEMENT: (a) THE LAND, PATHWAYS, FENCES, GROUNDS

PARKING SPACES, AND, LAUNDRY ROOMS AND FACILITIES: (b) THE FOUNDATIONS, COLUMNS, GIRDERS, BEAMS, SUPPORTS, BEARING WALLS, PERIMETER WALLS, ROOFS, AND EXTERIOR PORCHES, CORRIDORS, LOBBIES, STAIRS, FIRE ESCAPES, ENTRANCES AND EXITS OF THE BUILDING(S)

(c) INSTALLATIONS OF CENTRAL SERVICES, SUCH AS POWER, LIGHT, GAS, HOT AND COLD WATER, HEATING, REFRIGERATION, AIR CONDITIONING, WASTE DISPOSAL AND INCINERATORS, UP TO THE OUTLETS WITHIN ANY UNITS:

(d) THE TANKS, PUMPS, MOTORS, FANS, COMPRESSORS, DUCTS AND IN GENERAL, ALL APPARATUS AND INSTALLATIONS EXISTING FOR THE COMMON USE; AND (a) ALL OTHER ELEMENTS OF ANY BUILDING, NECESSARY OR

CONVENIENT TO ITS EXISTANCE, MAINTENANCE AND SAFETY. OR NORMALLY IN COMMON USE.

LIMITED COMMON ELEMENTS (L,C.E.)

THE FOLLOWING CONSTITUTE LIMITED COMMON ELEMENTS, THE USE OF WHICH SHALL BE RESTRICTED TO THE UNIT(s) TO WHICH

THEY PERTAIN:
(a) EACH UNIT IS ASSIGNED ONE EXTERIOR STORAGE AREA AND

ONE PARKING SPACE BEARING THE SAME NUMBER AS THE NUMBER OF THE UNIT, A UNITS IB THROUGH 21 ARE JOINTLY ASSIGNED THE STAIRWAYS LEADING TO THE SECOND STORY OF BUILDING THREE AND THE SECOND STORY PORCH CONNECTING THE ENTRANCES TO THOSE UNITS.

SHEET 2 = APPROVALS SHEET 3 = BUILDING DIMENSIONS & ELEVATIONS

EQUIPMENT: TOPCON "GUPPY" GTS IOD WITH 5 SECOND HORIZONTAL ACCURACY. LAST INSPECTED: FEBURARY, 1989 BY JOHNSON INSTRUMENT CO.

TERRA SURVEYING

DATE: DECEMBER, 1989 SCALE: || = 20 PROJECT: #8849

P.O. BOX 617 HOOD RIVER, OR. 97031 PHONE: (503) 386-4531 SHEET I of 3

DECLARATION:

KNOW ALL MEN BY THESE PRESENTS: THAT THE LODGE AT HOOD RIVER, INC., AN OREGON CORPORATION DOES HEREBY MAKE, ESTABLISH AND DECLARE THE ANNEXED MAP TO BE A TRUE, AND CORRECT MAP OF THE LAND OWNED AND LAID OUT BY THEM AS THE LODGE AT HOOD RIVER, PHASE 2. SAID LAND BEING MORE PARTICULARLY DESCRIBED IN THE SURVEYOR'S CERTIFICATE HERETO AFFIXED AND THEY DO HEREBY COMMIT SAID PROPERTY AND IMPROVEMENTS DESCRIBED AND DEPICTED ON THE PLAT ARE SUBJECT TO THE PROVISIONS OF O.R.S. 100.005 TO 100.990.

THE LODGE AT HOOD RIVER, INC.

GLEN D. HAACK, SECRETARY-TREASURER

ACKNOWLEDGEMENTS:
STATE OF OREGON

COUNTY OF HOOD RIVER } S.S.

BE IT REMEMBERED: THAT ON THIS 22 DAY OF Decampe, 1989, BEFORE ME A NOTARY PUBLIC IN AND FOR SAID STATE AND COUNTY PERSONALLY APPEARED GLEN D. HAACK, WHO BEING FIRST DULY SWORN, UNDER OATH, DID SAY THAT HE IS SECRETARY-TREASURER OF THE CORPORATION NAMED AND DESCRIBED IN THE FOREGOING INSTRUMENT AND THAT HIS SIGNATURE AND OFFICIAL CORPORATE SEAL AFFIXED TO SAID INSTRUMENT BY AUTHORITY OF ITS BOARD OF DIRECTORS ARE THE FREE ACT AND DEED OF SAID CORPORATION.

NOTARY PUBLIC FOR THE STATE OF OREGON

MY COMMISSION EXPIRES 12-12-1993



FILED FOR RECORD

THIS DAY OF 1990.

HOOD RIVER COUNTY DIRECTOR OF RECORDS AND ASSESSMENTS

PHASE 2 THE LODGE AT HOOD RIVER,

SURVEYOR'S AFFIDAVIT:

I, ROY O. GAYLORD, BEING FIRST DULY SWORN, DEPOSE AND SAY THAT I HAVE CORRECTLY SURVEYED AND MARKED WITH PROPER MONUMENTS THE LANDS REPRESENTED ON THE ANNEXED MAP OF "THE LODGE AT HOOD RIVER, PHASE 2" AND THAT FOR THE INITIAL POINT OF THE SURVEY I SET A 1,25" X 30" GALVANIZED PIPE WITH 2.5 INCH BRASS CAP ATTACHED, SET IN CONCRETE, 6 INCHES BELOW THE SURFACE OF THE GROUND. AND SAID INITIAL POINT BEING LOCATED NORTH 87"-44"-15" EAST ALONG THE NORTH LINE OF BLOCK 3 A DISTANCE OF 66.87 FEET FROM THE NORTHWEST CORNER OF SAID BLOCK 3. WAUCOMA ADDITION TO THE CITY OF HOOD RIVER: THENCE SOUTH 01"-11"-47" WEST PARALLEL WITH THE WEST LINE OF SAID BLOCK 3 A DISTANCS OF 49.67 FEET; THENCE SOUTH 86"-18"-56" EAST A DISTANCE OF 17.51 FEET; THENCE NORTH 87"-39"-22" EAST A DISTANCE OF 14.34 FEET; THENCE SOUTH 02"-15"-45" EAST A DISTANCE OF 29.80 FEET TO THE NORTH LINE OF OF "THE LODGE AT HOOD RIVER, PHASE I" AS PLATTED; THENCE SOUTH 87" 44" 15" WEST ALONG THE NORTH LINE OF SAID PLAT A DISTANCE OF 112.60 FEET TO A 5/8 INCH BY 30 INCH RON ROD WITH CAP SET IN THE WEST LINE OF SAID BLOCK 3; THENCE NORTH 01" II' 47" EAST ALONG SAID WEST LINE TO THE NORTHWEST BLOCK 3 CORNER; THENCE NORTH 87" 44" 15" EAST A DISTANCE OF 66.87 FEET ALONG THE NORTH LINE OF BLOCK 3 TO THE POINT OF BEGINNING.

I, ROY O. GAYLORD, A REGISTERED PROFESSIONAL LAND SURVEYOR CERTIFY THAT THE PLAT FULLY AND ACCURATELY DEPICTS THE BOUNDRIES OF THE UNITS OF THE BUILDING AND THAT THE CONSTRUCTION OF THE UNITS AND BUILDINGS AS DEPICTED ON THE PLAT HAS BEEN COMPLETED.

THIS 14 DAY OF DECEMBER 1989.

APPROVALS:

THE ANNEXED MAP OF THE LODGE AT HOOD RIVER, PHASE II WAS EXAMINED AND APPROVED BY ME

THIS 12 DAY OF JAN. 1990

THE ANNEXED MAP OF THE LODGE AT HOOD RIVER, PHASE II WAS EXAMINED AND APPROVED BY ME

THIS IS DAY OF AM, 1990.

THIS IS DAY OF AM, 1990.


HOOD RIVER CITY PLANNING COMMISSION

THE ANNEXED MAP OF THE LODGE AT HOOD RIVER, PHASE II WAS EXAMINED AND APPROVED BY ME

ROY O. GAYLORD

REGISTERED PROFESSIONAL

LAND SURVEYOR

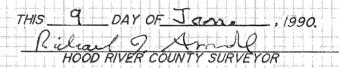

THE ANNEXED MAP OF THE LODGE AT HOOD RIVER, PHASE II WAS EXAMINED AND APPROVED BY ME

/	414	α	M	AYOR		rrys	CI	TY RE	CORL)FR			4
	11	1	7	6	1 1	12.5	1	1110	11		714		
- -	a 1	TH	5	12	_ DA	Y OI		MY	X	-,/99	0	1 4 1	
u da	abbb.		Sanadamania	La girana La calan	misoner frankrig	Emphory James	F S &	a da dan dain da	n,	And also Endown by its	i - Sine alam oku	- Anno Air A	

THE DIRECTOR OF RECORDS AND ASSESSMENTS AND THE DIRECTOR OF BUDGET AND FINANCE AND TAX COLLECTOR,
RESPECTIVELY OF HOOD RIVER COUNTY, OREGON. HEREBY CERTIFY THAT WE HAVE EXAMINED THE ANNEXED PLAT OF
"THE LODGE AT HOOD RIVER, PHASE 2", IN THE CITY OF HOOD RIVER AND THE NAME ADOPTED FOR SAID
PLAT IS A PROPER NAME AND NOT INCLUDED IN ANY OTHER SUBDIVISION IN HOOD RIVER COUNTY,
AND FURTHER CERTIFY THAT ALL ASSESSMENTS DUE HEREON HAVE BEEN FULLY PAID AS REQUIRED BY
LAW AND WE HEREBY APPROVE SAID PLAT.

HOOD RIVER COUNTY DIRECTOR OF BUDGET,
FINANCE AND TAX COLLECTOR

HOOD RIVER COUNTY DIRECTOR OF RECORDS

AND ASSESSMENTS




FEB 2, 1990 Cicharl 9 Anold COUNTY SURVEYOR

TERRA SURVEYING

DATE: DECEMBER, 1989 SCALE: I" = 20 PROJECT: #8849

P.O. BOX 617 HOOD RIVER, OR. 97031 PHONE: (503) 386-4531 SHEET 2 of 3

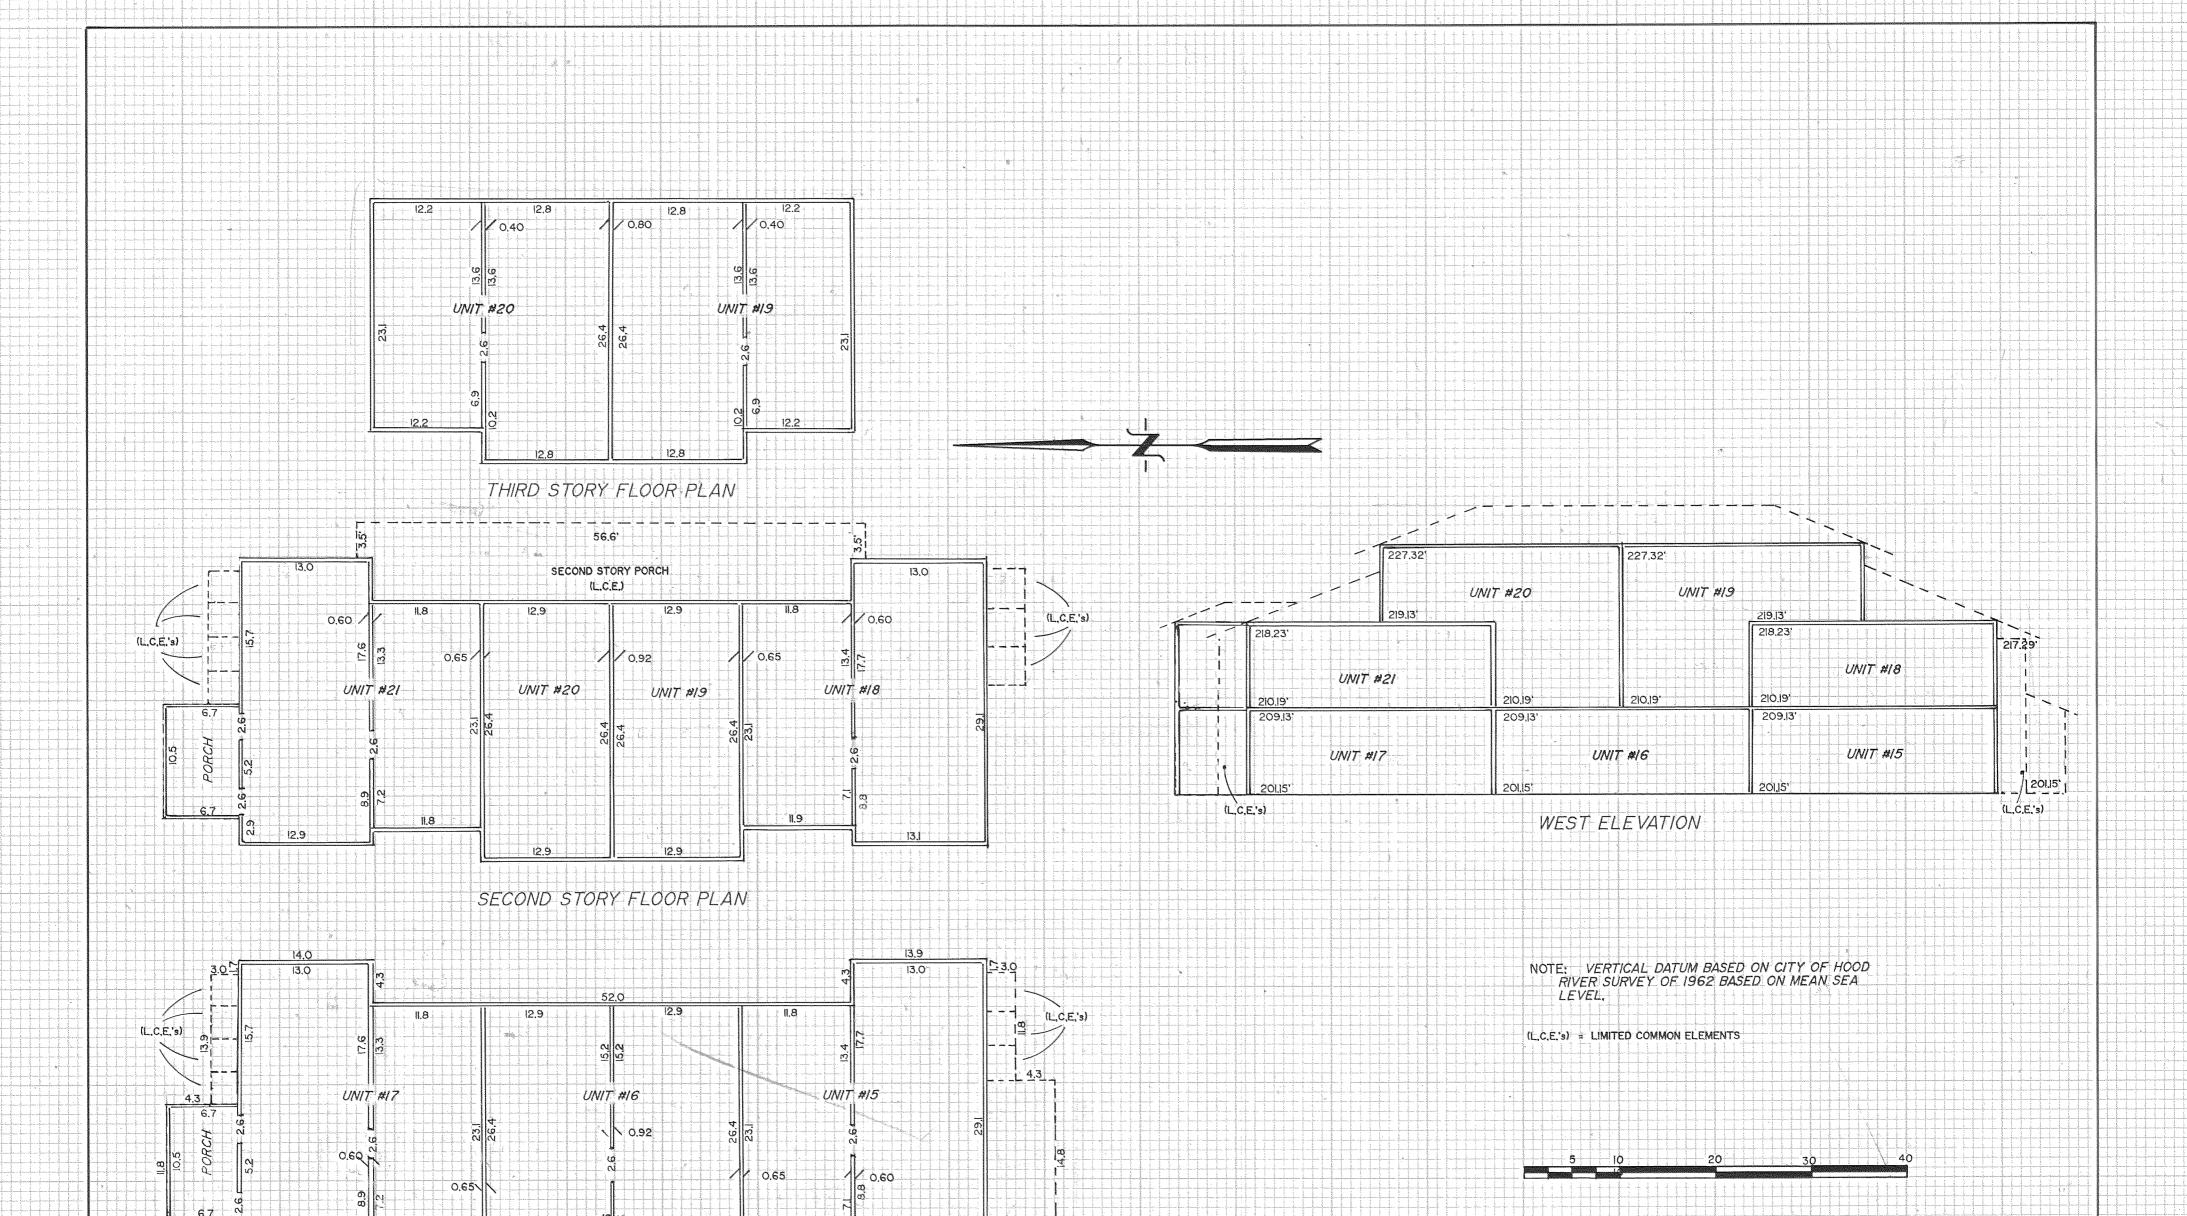

PHASE 2 THE LODGE

FIRST STORY FLOOR PLAN

AT HOOD RIVER,

BEING ALL A PART OF
BLOCK 3, WAUCOMA ADDITION TO THE
CITY OF HOOD RIVER,
COUNTY OF HOOD RIVER,
STATE OF OREGON.

FEB 2, 1990
Richard Charles
COUNTY SLEYEYOR

TERRA SURVEYING

DATE: DECEMBER, 1989
SCALE: 1" = 10'
PROJECT: #8849

P.O. BOX 617 HOOD RIVER, OR. 97031 PHONE: (503) 386-4531 SHEET 3 61 3