

LEGEND

- PERMANENT MONUMENT
- ⊗ ORIGINAL CORNER RECOVERED
- ⊙ EVIDENCE RECOVERED
- SEARCHED, NOT FOUND

FILING INSTRUCTION

File 5680-2 card record by letter and number coordinates behind the file guide for the township in which it falls.


File the 5680-2 card record by letter and then by number i.e., all A cards first, then B cards etc.

The first card behind the file guide (if data have been obtained and recorded) will be card A-1 for N.W. Township Corner, then card A-2 for 1/16 corner then card A-3 for 1/4 corner etc.

CORNER RECORD FILE GUIDE (Rectangular Surveys)

1. T 1 S R 8 1/2 E No. A 28 Cor. 1/4 Mer. Will State Oregon (Rectangular) N. F. Mt. Hood Dist. Hood River

2. Corner Status

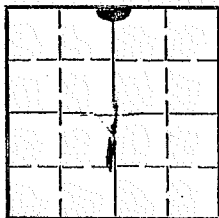

Common to lowly

7. Photo Identification

Photo No. _____

Ident. By: _____

8. Plane Coordinate Position Data

State _____ Zone _____

X _____

Y _____

Estab. By _____

Field Book No. _____

Where Filed _____

9. Evaluation

Authentic _____

Needs Verif. _____ Monument _____

Re-estab. _____ Survey _____

Land Status _____

3. Original Description _____ Vol. _____ Page _____ Where Recorded _____

4. Description of Corners: 3/4" Iron pipe, galvanized, 10" above ground, excellent condition, Brass hub and Rock cairn,
DFir - 30" DBH, Brs 528E, 15ft. dist, Live, Good, Iron marks
partly overgrown, partly visible,
DFir - 28" DBH, Brs 569W, 55ft. dist, Live, Good, Iron marks
partly visible, partly overgrown

6LO
1940


5. Investigation Notes:

6. Signed E.S. NANCE Title Tech. For. Date 4/6/67

LAND CORNER RECORD

1. T 15 R 8 1/2 E No. E-19 ~~7-17~~ Cor. SFC Mer. W State OREGON N. F. MT HOOD Dist. HOOD RIVER

2. Corner Status

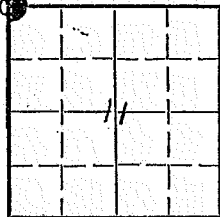

Commenced to 2, 11

7. Photo Identification

Photo No. _____
Ident. By: _____

8. Plane Coordinate Position Data

State _____ Zone _____
X _____
Y _____
Etab. By _____
Field Book No. _____
Where Filed _____

9. Evaluation


Authentic YES
Needs Verif. Monument
Re-estab. Survey
Land Status _____

3. Original Description _____ Vol. _____ Page _____ Where Recorded _____

4. Description of Corners:

5. Investigation Notes:

IRON PIPE IN PLACE, GOOD CONDITION, 2" x 12" ABOVE GROUND
MOUND OF ROCK EAST OF CORNER
MARKS ON TREES BT₃ T15 R8 1/2 E 511, T15 R8 1/2 E 52
SPEC. DIM. BER DIS. (CORNER IS JUST WEST OF JONES CR. RD.)
D. FIR 18" 570°E 2H'
D. FIR 12" N HOPE 60'

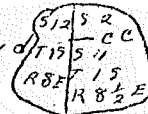

6. Signed VAN B. Embree Title GUARD


Date 1946

LAND CORNER RECORD

(Rectangular)

1. T. 19 R. 85 E No. E-23 Cor. 1/4 Mer. W State OREGON N. F. MT HOOD Dist. HOOD RIVER

2. Corner Status

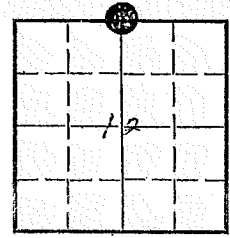

Common to 1, 12.

7. Photo Identification

Photo No. _____

Ident. By: _____

8. Plane Coordinate Position Data

State _____ Zone _____

X _____

Y _____

Estab. By _____

Field Book No. _____

Where Filed _____

9. Evaluation

Authentic YES

Needs Verif. _____ Monument

Re-estab. _____ Survey _____

Land Status _____

3. Original Description _____ Vol. _____ Page _____ Where Recorded _____

4. Description of Corners:

5. Investigation Notes:


IRON PIPE WITH CAP IN PLACE AND IN GOOD CONDITION, 14 INCHES ABOVE GROUND, MARKINGS ON CAP $\frac{1}{12}$ MOUND OF ROCKS LOCATED BESIDE CORNER. NO BEARING TAFFES. CORNER IS ALONG LOLA PASS RD. Section line marker between Secs. 1 and 12 is on a post on the Lola Pass road located $1\frac{1}{2}$ chains W from $\frac{1}{4}$ corner.

6. Signed J. W. PEDERSON Title DIST. ASST. Date 12-13-54

(Rectangular)

1. T 1S R 8¹/₂E No. 5-19 ~~5-17~~ Cor. SecMer. Wm. State Oregon N. F. Mt. Hood Dist. Hood River

2. Corner Status

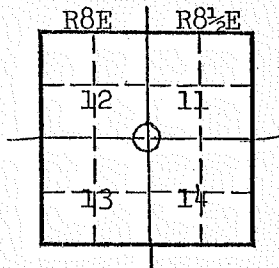

7. Photo Identification

Photo No. _____

Ident. By: _____

8. Plane Coordinate Position Data

State _____ Zone _____

X _____

Y _____

Estab. By _____

Field Book No. _____

Where Filed _____

9. Evaluation

Authentic _____

Needs Verif. _____ Monument _____

Re-estab. _____ Survey _____

Land Status _____

3. Original Description _____ Vol. _____ Page _____ Where Recorded _____

4. Description of Corners:

No Monument found

5. Investigation Notes:

One Bearing tree located, 30"DBH, Douglas Fir. Balzed trail follows section line.

6. Signed Harry Rector Title Frstry Techs


Date 9/16/76

LAND CORNER RECORD

(Rectangular)

1. T. 15 R. 8 1/2 E No. J-21 Cor. SEC Mer. W State OREGON N. F. MT. HOOD Dist. HOOD RIVER

2. Corner Status _____

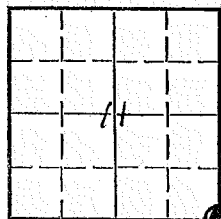

Commenced to 11, 12, 13, 14

7. Photo Identification

Photo No. _____

Ident. By: _____

8. Plane Coordinate Position Data

State _____ Zone _____

X _____

Y _____

Estab. By _____

Field Book No. _____

Where Filed _____

9. Evaluation

Authentic YES

Needs Verif. Monument

Re-estab. Survey

Land Status _____

3. Original Description _____ Vol. _____ Page _____ Where Recorded _____

4. Description of Corners:

5. Investigation Notes:

PIPE WITH BRASS CAP IN PLACE ALSO GOOD CONDITION, 12" ABOVE GROUND
 B.T.S. SPEC. DIA. ~~1 1/2~~ DIS. CORNER IS 18 CHS EAST OF LOLO PASS RD.
 DF 26" 225° 8'
 DF 22" 320° 35'
 DF 20" 115° 35'


6. Signed EVEN E JONES Title TMA Date 8-1-55

LAND CORNER RECORD

5680-2

1. T 15 R 8 1/2 No. J-23 Cor. 1/4 Mer. 1/4 State OREGON (Rectangular) N. F. MT Hood Dist. HOOD RIVER

2. Corner Status

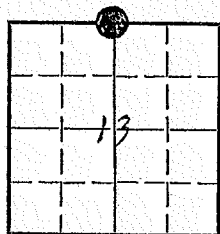

Comment to 12, 13

7. Photo Identification

Photo No. _____

Ident. By: _____

8. Plane Coordinate Position Data

State _____ Zone _____

X _____

Y _____

Estab. By _____

Field Book No. _____

Where Filed _____

9. Evaluation

Authentic YES

Needs Verif. Monument ✓

Re-estab. Survey

Land Status _____

3. Original Description _____ Vol. _____ Page _____ Where Recorded _____

4. Description of Corners:

5. Investigation Notes:

1" PIPE WITH BRASS CAP IN GOOD CONDITION, 12 IN. ABOVE GROUND,
MOUND OF ROCK IS LOCATED 2' NE

B.T.S MARKS ON TREES 1/4 S 12
SPEC. DIAM. A2 115.
H 20" 50° 15'
NF 22" 160° 30'


6. Signed EVAN E JONES Title TMA

Date 7-25-55

(Rectangular)

1. T 15 R 8 1/2 E No. L-21 Cor. 1/4 Mer. W State OREGON N. F. MT HOOD Dist. HOOD RIVER

2. Corner Status _____

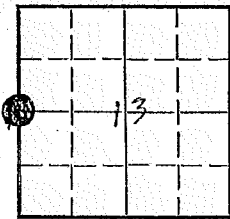

Common to 14, 13

7. Photo Identification

Photo No. _____

Ident. By: _____

8. Plane Coordinate Position Data

State _____ Zone _____

X _____

Y _____

Estab. By _____

Field Book No. _____

Where Filed _____

9. Evaluation

Authentic YES

Needs Verif. _____ Monument

Re-estab. _____ Survey _____

Land Status _____

3. Original Description _____ Vol. _____ Page _____ Where Recorded _____

4. Description of Corners: _____

5. Investigation Notes:

IRON PIPE WITH 6 2.0 BRASS CAP ALSO PILE OF ROCKS IN GOOD CONDITION
 12" ABOVE GROUND 1940 SURVEY B.T.S. DE 20" 205° 30' 12"
 SPEC. DIM. HZ. DIS. DE 28" 83° 6' 15"


6. Signed EVERETT E. JONES Title FORESTER Date 1956

LAND CORNER RECORD

(Rectangular)

1. T. 15 R. 8 1/2 E No. N-10 ~~117~~ Cor. SFC Mer. W State OREGON N. F. MT. HOOD Dist. HOOD RIVER

2. Corner Status

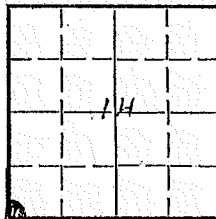

Common to 14, 23

7. Photo Identification

Photo No. _____

Ident. By: _____

8. Plane Coordinate Position Data

State _____ Zone _____

X _____

Y _____

Estab. By _____

Field Book No. _____

Where Filed _____

9. Evaluation

Authentic YES

Needs Verif. _____ Monument

Re-estab. _____ Survey _____

Land Status _____

3. Original Description _____ Vol. _____ Page _____ Where Recorded _____


4. Description of Corners:

5. Investigation Notes:

IRON PIPE WITH BRASS CAP, 1 1/2" x 10" ABOVE GROUND
MOUND OF ROCK IS LOCATED EAST OF PIPE
NO BEARING TREES

This corner is 35ft north of Tony Creek Trail.

ON TOP OF CAP

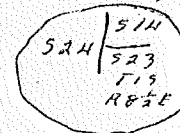

6. Signed PAH B. Amber Title Guard


Date MAY 16, 1947

LAND CORNER RECORD

5680-2

1. T. 15. R. 8 1/2 E. No. N-21 Cor. Mer. W. 11. State Oregon (Rectangular) N. F. Mt. Hood Dist. Hood River

2. Corner Status

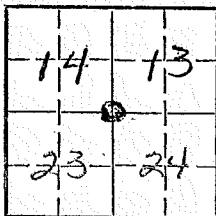

7. Photo Identification

Photo No. _____

Ident. By: _____

8. Plane Coordinate Position Data

State _____ Zone _____

X _____

Y _____

Estab. By _____

Field Book No. _____

Where Filed _____

9. Evaluation

Authentic _____

Needs Verif. _____ Monument _____

Re-estab. _____ Survey _____

Land Status _____

3. Original Description _____ Vol. _____ Page _____ Where Recorded _____

4. Description of Corners: Rock Cairn 2 1/2 ft. high. Good Condition. 1 1/2" Galvanized iron pipe with BRASS Cap. 10" above ground. Good Condition.
A hemlock 14.3" in dia. Brs S 64° E. 256' Dist. Live. Good. Iron marks partly visible.
A DF 23.7" in dia. Brs S 67° W. 450' Dist. Live. Good. Face open. pitched over. Not legible.

US GLO
 514 513
 525 524
 1940
 Survey

5. Investigation Notes:


A hemlock 21.6" in dia. Brs N 30° W 22.0' Dist. Live. Good. Iron marks partly visible
a hemlock 16.7" in dia. Brs N 56° E. 17.7' Dist. Live. Good. Iron Marks partly visible.

6. Signed E.S. Nance Title Forestry Tech. Date 6-13-67

LAND CORNER RECORD

1. T. 15 R. 82E No. 14-23 Cor. 1/4 Mer. W State OREGON (Rectangular) N. F. MT Hood Dist. HOOD RIVER

2. Corner Status _____

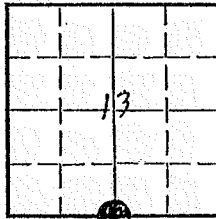

Common to 13, 24

7. Photo Identification

Photo No. _____

Ident. By: _____

8. Plane Coordinate Position Data

State _____ Zone _____

X _____

Y _____

Estab. By _____

Field Book No. _____

Where Filed _____

9. Evaluation

Authentic YES

Needs Verif. _____ Monument ✓

Re-estab. _____ Survey _____

Land Status _____

3. Original Description _____ Vol. _____ Page _____ Where Recorded _____

4. Description of Corners: _____

5. Investigation Notes:

IRON PIPE WITH BRASS CAP, $3\frac{1}{4}$ " x 10" ABOVE GROUND, TOP OF CAP 13
4 5 24
 B.T.S. SPE. DIA. BEA. DIS. MARKING ON B.T.S.
 D FIR 24" N30°E 30' 1/4 S 13
 D FIR 32" S05°W 25' 1/4 S 24

CORNER IS SOUTH OF DOLLOR ROAD
 Section Line Marker is on a tree on the Tony Creek Trail 106ft E of 1/4 corner.


6. Signed VAH B Embree Title GUARD Date MAY 1947

LAND CORNER RECORD

(Rectangular)

1. T. 15 R. 82 E No. P-21 Cor. 1/4 Mer. N State OREGON N. F. MT. HOOD Dist. HOOD RIVER

2. Corner Status

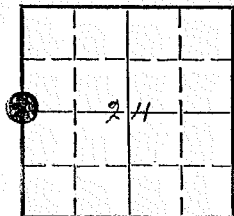

Comment To 23, 24

7. Photo Identification

Photo No. _____

Ident. By: _____

8. Plane Coordinate Position Data

State _____ Zone _____

X _____

Y _____

Estab. By _____

Field Book No. _____

Where Filed _____

9. Evaluation

Authentic YES

Needs Verif. _____ Monument

Re-estab. _____ Survey _____

Land Status _____

3. Original Description _____ Vol. _____ Page _____ Where Recorded _____

4. Description of Corners:

5. Investigation Notes:


IRON PIPE IN PLACE WITH BRASS CAP ON MOUND OF ROCK, GOOD CONDITION,
 18" INCHES ABOVE GROUND B.T.S SPEC. DIM. AZ DIS.
 DF 24" 218° 4'
 DF 16" 67° 40'

6. Signed EVAN F JONES Title TMA

Date 7-21-55

1. T1S • R8 1/2 E No. R-19 Cor. Sec. Mer. Will State Oregon N. F. Mt. Hood Dist. Hood River
 (Rectangular)

2. Corner Status

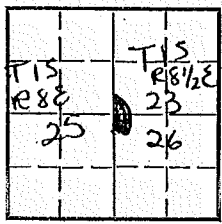

7. Photo Identification

Photo No. _____

Ident. By: _____

8. Plane Coordinate Position Data

State _____ Zone _____

X _____

Y _____

Estab. By _____

Field Book No. _____

Where Filed _____

9. Evaluation

Authentic _____

Needs Verif. _____ Monument _____

Re-estab. _____ Survey _____

Land Status _____

3. Original Description _____ Vol. _____ Page _____ Where Recorded _____

4. Description of Corners: 2" Galvanized Iron Pipe with Brass cap, 8" above ground
 Good Condition, Markings on cap - T1S T1S
R8 1/2 E R8 1/2 E
 Rock cairn 3' across 2 1/2' high 25 23 26
 No BT

5. Investigation Notes:


6. Signed E.S. Nance Title For. Tech Date 4/25/68

LAND CORNER RECORD

(Rectangular)

1. T. 15 R. 8 1/2 No. R-23 Cor. 1/4 Mer. W State OREGON N. F. MT HOOD Dist. HOOD RIVER

2. Corner Status

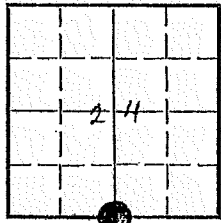

Common to 24, 25

7. Photo Identification

Photo No. _____

Ident. By: _____

8. Plane Coordinate Position Data

State _____ Zone _____

X _____

Y _____

Estab. By _____

Field Book No. _____

Where Filed _____

9. Evaluation

Authentic YES

Needs Verif. Monument ✓

Re-estab. Survey

Land Status _____

3. Original Description _____ Vol. _____ Page _____ Where Recorded _____

4. Description of Corners:

5. Investigation Notes:

PIPE WITH BRASS CAP IN PLACE AND GOOD CONDITION
 B.T.S. SPEC. DIM. EZ DIS. B.T.S. MARKING ON TREES
 # 22" DUE. N 17' 1/4 5 24
 # 20" 230° 18' 1/4 5 25
 ELEVATION: 3960'

6. Signed EVAN F. JONES Title TMA Date 8-31-55

Index

CORNER RECORD (SEARCH)

Tract or
Survey No.

Cor.
No. Sec.

File No. V-21

(Ref. FSM 7151.4)


T. 1S R. 8 1/2 E

R.D. Hood River County Hood River

Merid. _____

N.F. mt. Hood State OREGON

CORNER DIAGRAM

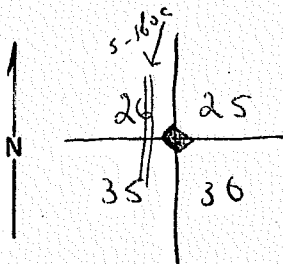

DESCRIBE CORNER MONUMENT FOUND

GLO Brass cap 1/2", 4" above ground - mound of rocks
2' high & 3' at the base

2

DESCRIBE BEARING TREES OR OTHER OFFICIAL ACCESSORIES FOUND

Bearings are from tree to corner -

D.F. 22" 32' @ 335°

D.F. 22" 40' @ 227°

D.F. 20" 30' @ 125°

D.F. 26" 18' @ 78°

3

PHOTO IDENTIFICATION DATA

Photo No. _____

Filed At. _____

Object Ident. _____

Ident. By _____

Signature

PLANE COORDINATE POSITION DATA

State _____ Zone _____

X _____

Y _____

Estab. By _____

Agency

DESCRIBE CORNER LOCATION RELATIVE TO NEAR-BY FEATURES, ALSO HOW TO REACH CORNER

Location Poster on Road 5-160C. Corner is 168' East of
this poster. There is East-west blaze line.

4

Signature

Title

Division

Headquarters

Date

7100-52 (3/68)

d. Rector, D. Beers

For. Tech.


5-23-79

5

LAND CORNER RECORD

1. T 5 R 8 1/2 No. K-21 Cor. SEC Mer. W State OREGON (Rectangular) N. F. MT. HOOD Dist. HOG & RIVER

2. Corner Status

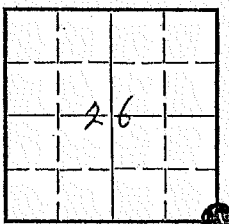

Comment To 25, 26, 35, 36

7. Photo Identification

Photo No. _____

Ident. By: _____

8. Plane Coordinate Position Data

State _____ Zone _____

X _____

Y _____

Estab. By _____

Field Book No. _____

Where Filed _____

9. Evaluation

Authentic YES

Needs Verif. _____ Monument

Re-estab. _____ Survey _____

Land Status _____

3. Original Description _____ Vol. _____ Page _____ Where Recorded _____

4. Description of Corners:

5. Investigation Notes:

PIPE WITH BRASS CAP IN PLACE ALSO GOOD CONDITION, MOUND OF ROCK IS LOCATED AROUND PIPE

B.T.S	SPEC.	DIM.	AZ	DIST.
-	DF	24"	260°	16'
-	DF	18"	320°	30'
-	DF	18"	160°	25'
-	DF	16"	55°	30'

6. Signed EVEN E JONES Title T M A

Date 8-1-55


LAND CORNER RECORD

5680

(Rectangular)

1. T. 15 R. 83E No. X-21 Cor. 1/4 Mer. W State OREGON N. F. MT Hood Dist. HOOD RIVER

2. Corner Status

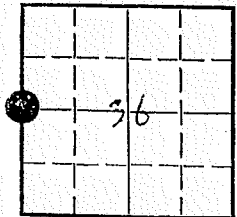

Common to 35, 36

7. Photo Identification

Photo No. _____

Ident. By: _____

8. Plane Coordinate Position Data

State _____ Zone _____

X _____

Y _____

Estab. By _____

Field Book No. _____

Where Filed _____

9. Evaluation

Authentic YES

Needs Verif. _____ Monument ✓

Re-estab. _____ Survey _____

Land Status _____

3. Original Description _____ Vol. _____ Page _____ Where Recorded _____

4. Description of Corners:

5. Investigation Notes:

IRON PIPE WITH BRASS CAP IN PLACE ALSO GOOD CONDITION;
MOUND OF ROCK IS LOCATED 2' WEST OF PIPE

B.T.S	SPEC.	DIM.	AZ.	DIS.
	DF	20"	315°	43'
	UF	22"	85°	28'

6. Signed EVAN E JONES Title TMA

Date 8-31-55


Index
File No. 7-17 Z-19

CORNER RECORD (SEARCH)
(Ref. FSM 7151.4)

Tract or Survey No. _____
Cor. No. Sec 35

T 15' R. 8 1/2 E R.D. Hood River County Hood River
Merid. Willamette N.F. Mt. Hood State Oregon

CORNER DIAGRAM

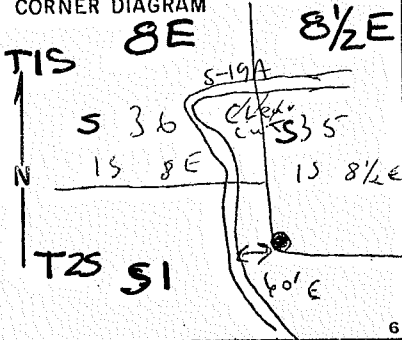

DESCRIBE CORNER MONUMENT FOUND

Iron Pipe 4" Diameter 12' Above ground Brass
cap mound of rocks.

PHOTO IDENTIFICATION DATA

Photo No. _____
Filed At. _____
Object Ident. _____
Ident. By _____
Signature _____

DESCRIBE BEARING TREES OR OTHER OFFICIAL ACCESSORIES FOUND

10" Hemlock 5 stump from 5 stump to corner
Brs 1920 24 lks no scribing
24" hemlock 240° 38 lks scribing visible &
legible.

PLANE COORDINATE POSITION DATA

State _____ Zone _____
X _____
Y _____
Estab. By _____
Agency _____

DESCRIBE CORNER LOCATION RELATIVE TO NEAR-BY FEATURES, ALSO HOW TO REACH CORNER

corner can be reached from S-19A By
going East from Road 60' -

Signature Larry Hector Title loc. tech. Division _____ Headquarters _____ Date 9-21-79
7100-52 (3/68)

Index

File No. 2-19

CORNER RECORD (SEARCH)

(Ref. FSM 7151.4)

Tract or Survey No. _____

Cor. 1/4 35
No. _____


T 1S R. 8 1/2 E

R.D. Hood River County Hood River

Merid. Willamette

N.F. Mt. Hood State Oregon

CORNER DIAGRAM

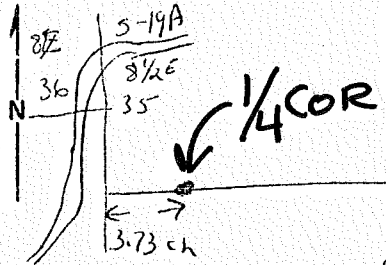

DESCRIBE CORNER MONUMENT FOUND

From pipe Brass cap 2" 12" Above ground mound of rocks

DESCRIBE BEARING TREES OR OTHER OFFICIAL ACCESSORIES FOUND

14" Hemlock sing 124° 131ks scribing visible & legible
14" Hemlock 220° 381ks no scribing-

PHOTO IDENTIFICATION DATA

Photo No. _____
Filed At. _____
Object Ident. _____
Ident. By _____
Signature _____

DESCRIBE CORNER LOCATION RELATIVE TO NEAR-BY FEATURES, ALSO HOW TO REACH CORNER

Corner - 15 3.73 ch. E of a sec^{sw} corner 35

PLANE COORDINATE POSITION DATA

State _____ Zone _____
X _____
Y _____
Estab. By _____
Agency _____

Signature

Title

Division

Headquarters

Date


7100-52 (3/66)

LARRY REGTOR TM

9-79

1. T 18 R 8 1/2 E No. 247 Cor. Mer Will State Oregon (Rectangular) N. F. Mt Hood Dist. Hood River

2. Corner Status

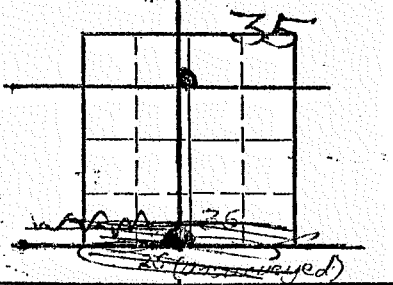

7. Photo Identification
 Photo No. _____
 Ident. By: _____

8. Plane Coordinate Position Data
 State _____ Zone _____
 X _____
 Y _____
 Estab. By _____
 Field Book No. _____
 Where Filed _____

9. Evaluation
 Authentic _____
 Needs Verif. _____ Monument _____
 Re-estab. _____ Survey _____
 Land Status _____

3. Original Description _____ Vol. _____ Page _____ Where Recorded _____

4. Description of Corners: *Corners may be reached from clear-cut logging area. Fire trail is 2ch W of corner.*

5. Investigation Notes:


6. Signed ESM VRE Title For Tech TMA Date 6/16/65

LAND CORNER RECORD

(Rectangular)

T. 1S R. 9E No. A 11 Cor. $\frac{1}{4}$ Mer. WM State Oregon N. F. Mt. Hood Dist. Hood River

2. Corner Status

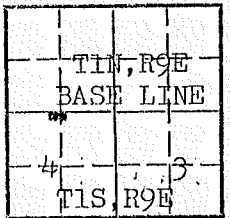

COMMON TO 4 T1S, R9E

7. Photo Identification

Photo No. _____

Ident. By: _____

8. Plane Coordinate Position Data

State _____ Zone _____

Estab. By _____

Field Book No. _____

Where Filed _____

9. Evaluation

Authentic _____


Needs Verif. Monument

Re-estab. Survey

Land Status _____

3. Original Description _____ Vol. _____ Page _____ Where Recorded _____

4. Description of Corners: Corner consists of a iron pipe in place. Good condition. Dimensions above ground $3/4 \times 12$ ". Mound of rock.

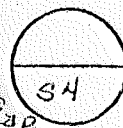

BRASS CAP

5. Investigation Notes:

$\frac{1}{4}$ S4	$\frac{1}{4}$ S4
B.T.	B.T.

Species D.Fir D.Fir

Diameter 22" 22"

Bearing S.W. S.E.

Distance 18 40

Believed to be a genuine Land Office Corner.

6. Signed C. Welty Title _____ Date 1942