

~~OREGON STATE HIGHWAY DEPARTMENT~~
~~Located Line~~
~~DEE ~ PARKDALE SECTION~~
~~HOOD RIVER SECONDARY No. 281~~
~~HOOD RIVER COUNTY~~

~~Scale: 1" = 100'~~ ~~Bearings True~~
~~J. E. Peck Res. Engr.~~ ~~1940.~~
~~T. I. N., R. 10 E., W. M.~~

OREGON STATE HIGHWAY DEPARTMENT
 Constructed Line
DEE ~ WOODWORTH ACRES SECTION
HOOD RIVER SECONDARY
 HOOD RIVER COUNTY

Scale: 1 in. = 100 ft Bearings True.
 J. E. Peck Des Engr November 1941.
 T. I. N. R. 10 E. W. M.

Contract No. 2480
 Station 37+28 to Station 203+50
 Work Commenced August 18, 1941
 Work Completed December 27, 1941

4F 16-11
 S.H. 1




T. I. N. R. 10 E.
 T. I. N. R. 9 E.

Oregon Lumber Co.
E 1/2 of N.W. 1/4 + E. 1/2 of S.W. 1/4 Sec. 7
7-602

DEE

Oregon Lumber Co.
West 1/2 of West 1/2 of Sec. 7
G-610


4F 16-11
SH.2

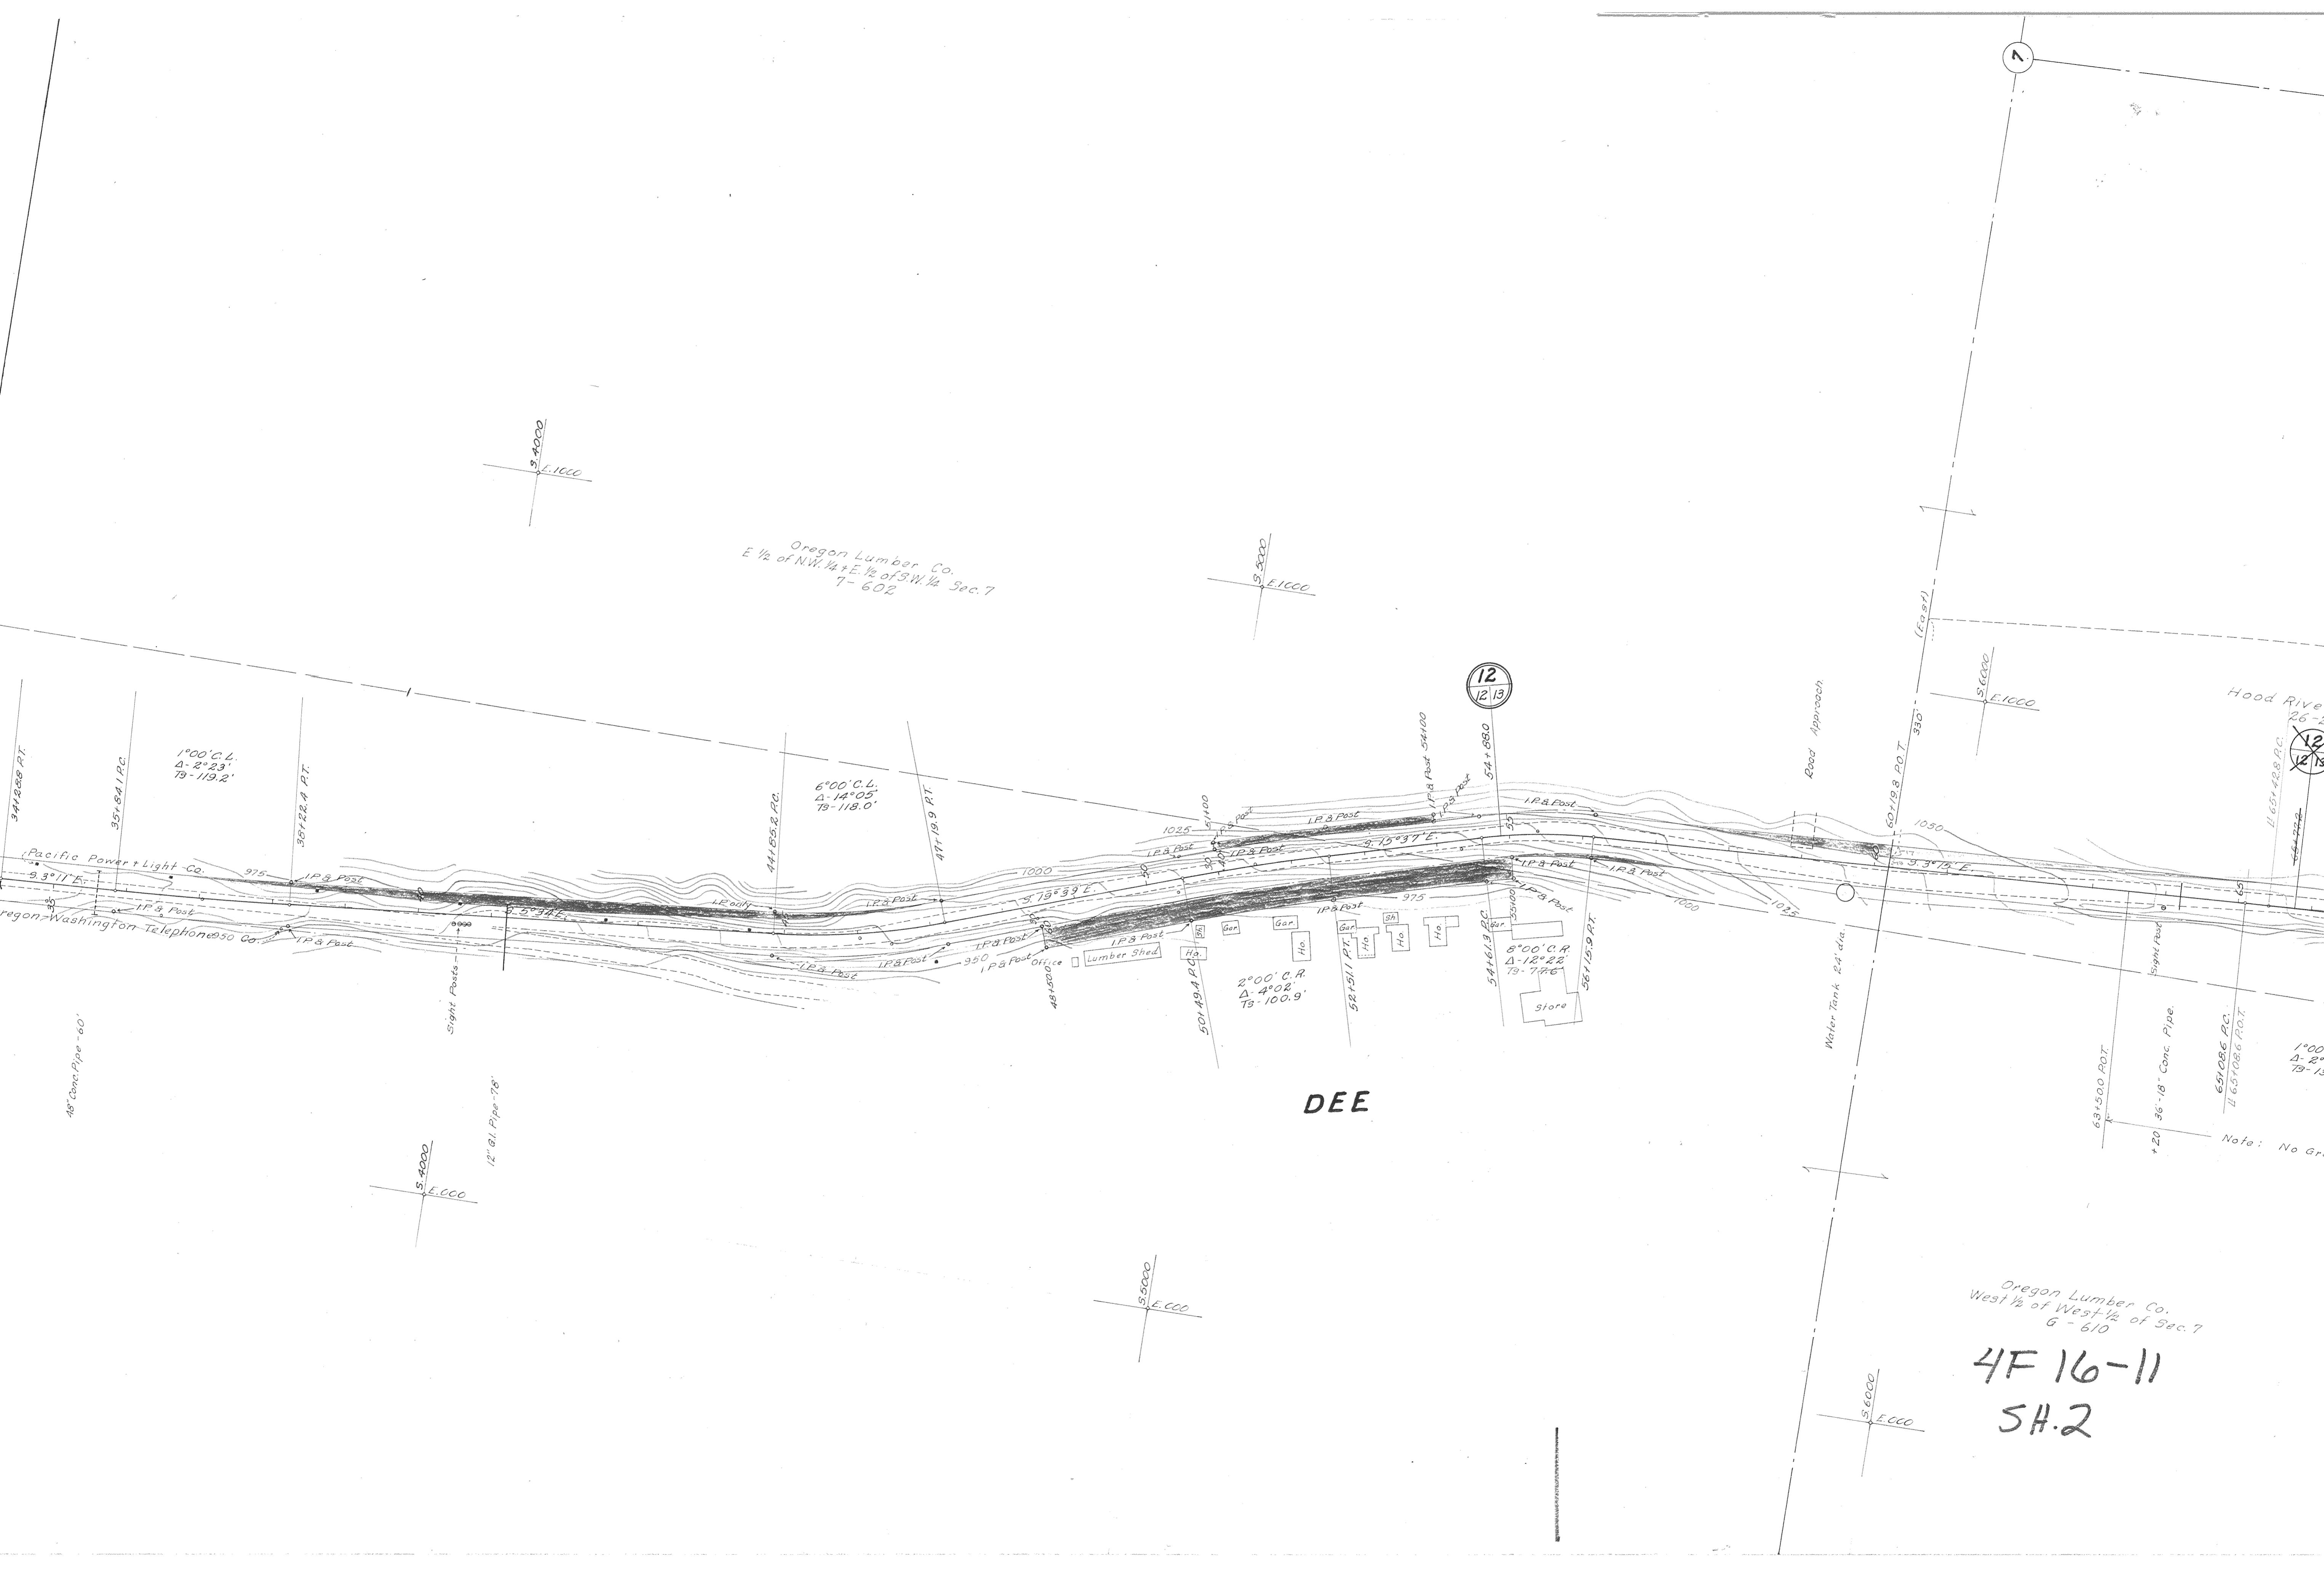

Note: No Gr.



Hood River County
26-24

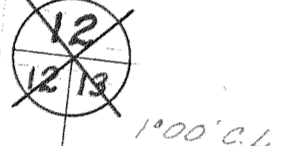

100' C.L.
Δ = 2°06'
R = 105.0'

100' C.L.
Δ = 4°00'
R = 200.1'

500' C.L.
Δ = 13°38'
R = 137.0'

100' C.L.
Δ = 15°03'
R = 227.5'

100' C.P.
Δ = 2°47'
R = 139.2'

10° C.P.
Δ = 11°39'
R = 55.5'

Note: No Grading to be done from Sta. 63+50 to Sta. 130+00

Established from
Bearing Tree Fd.


Abandoned
1st recon...

umber Co.
+ 1/2 of Sec. 7
10

o-11

+01 39'-18" Conc. Pipe

1654.9 to Per. Co. 12.18-7.18 Fd.

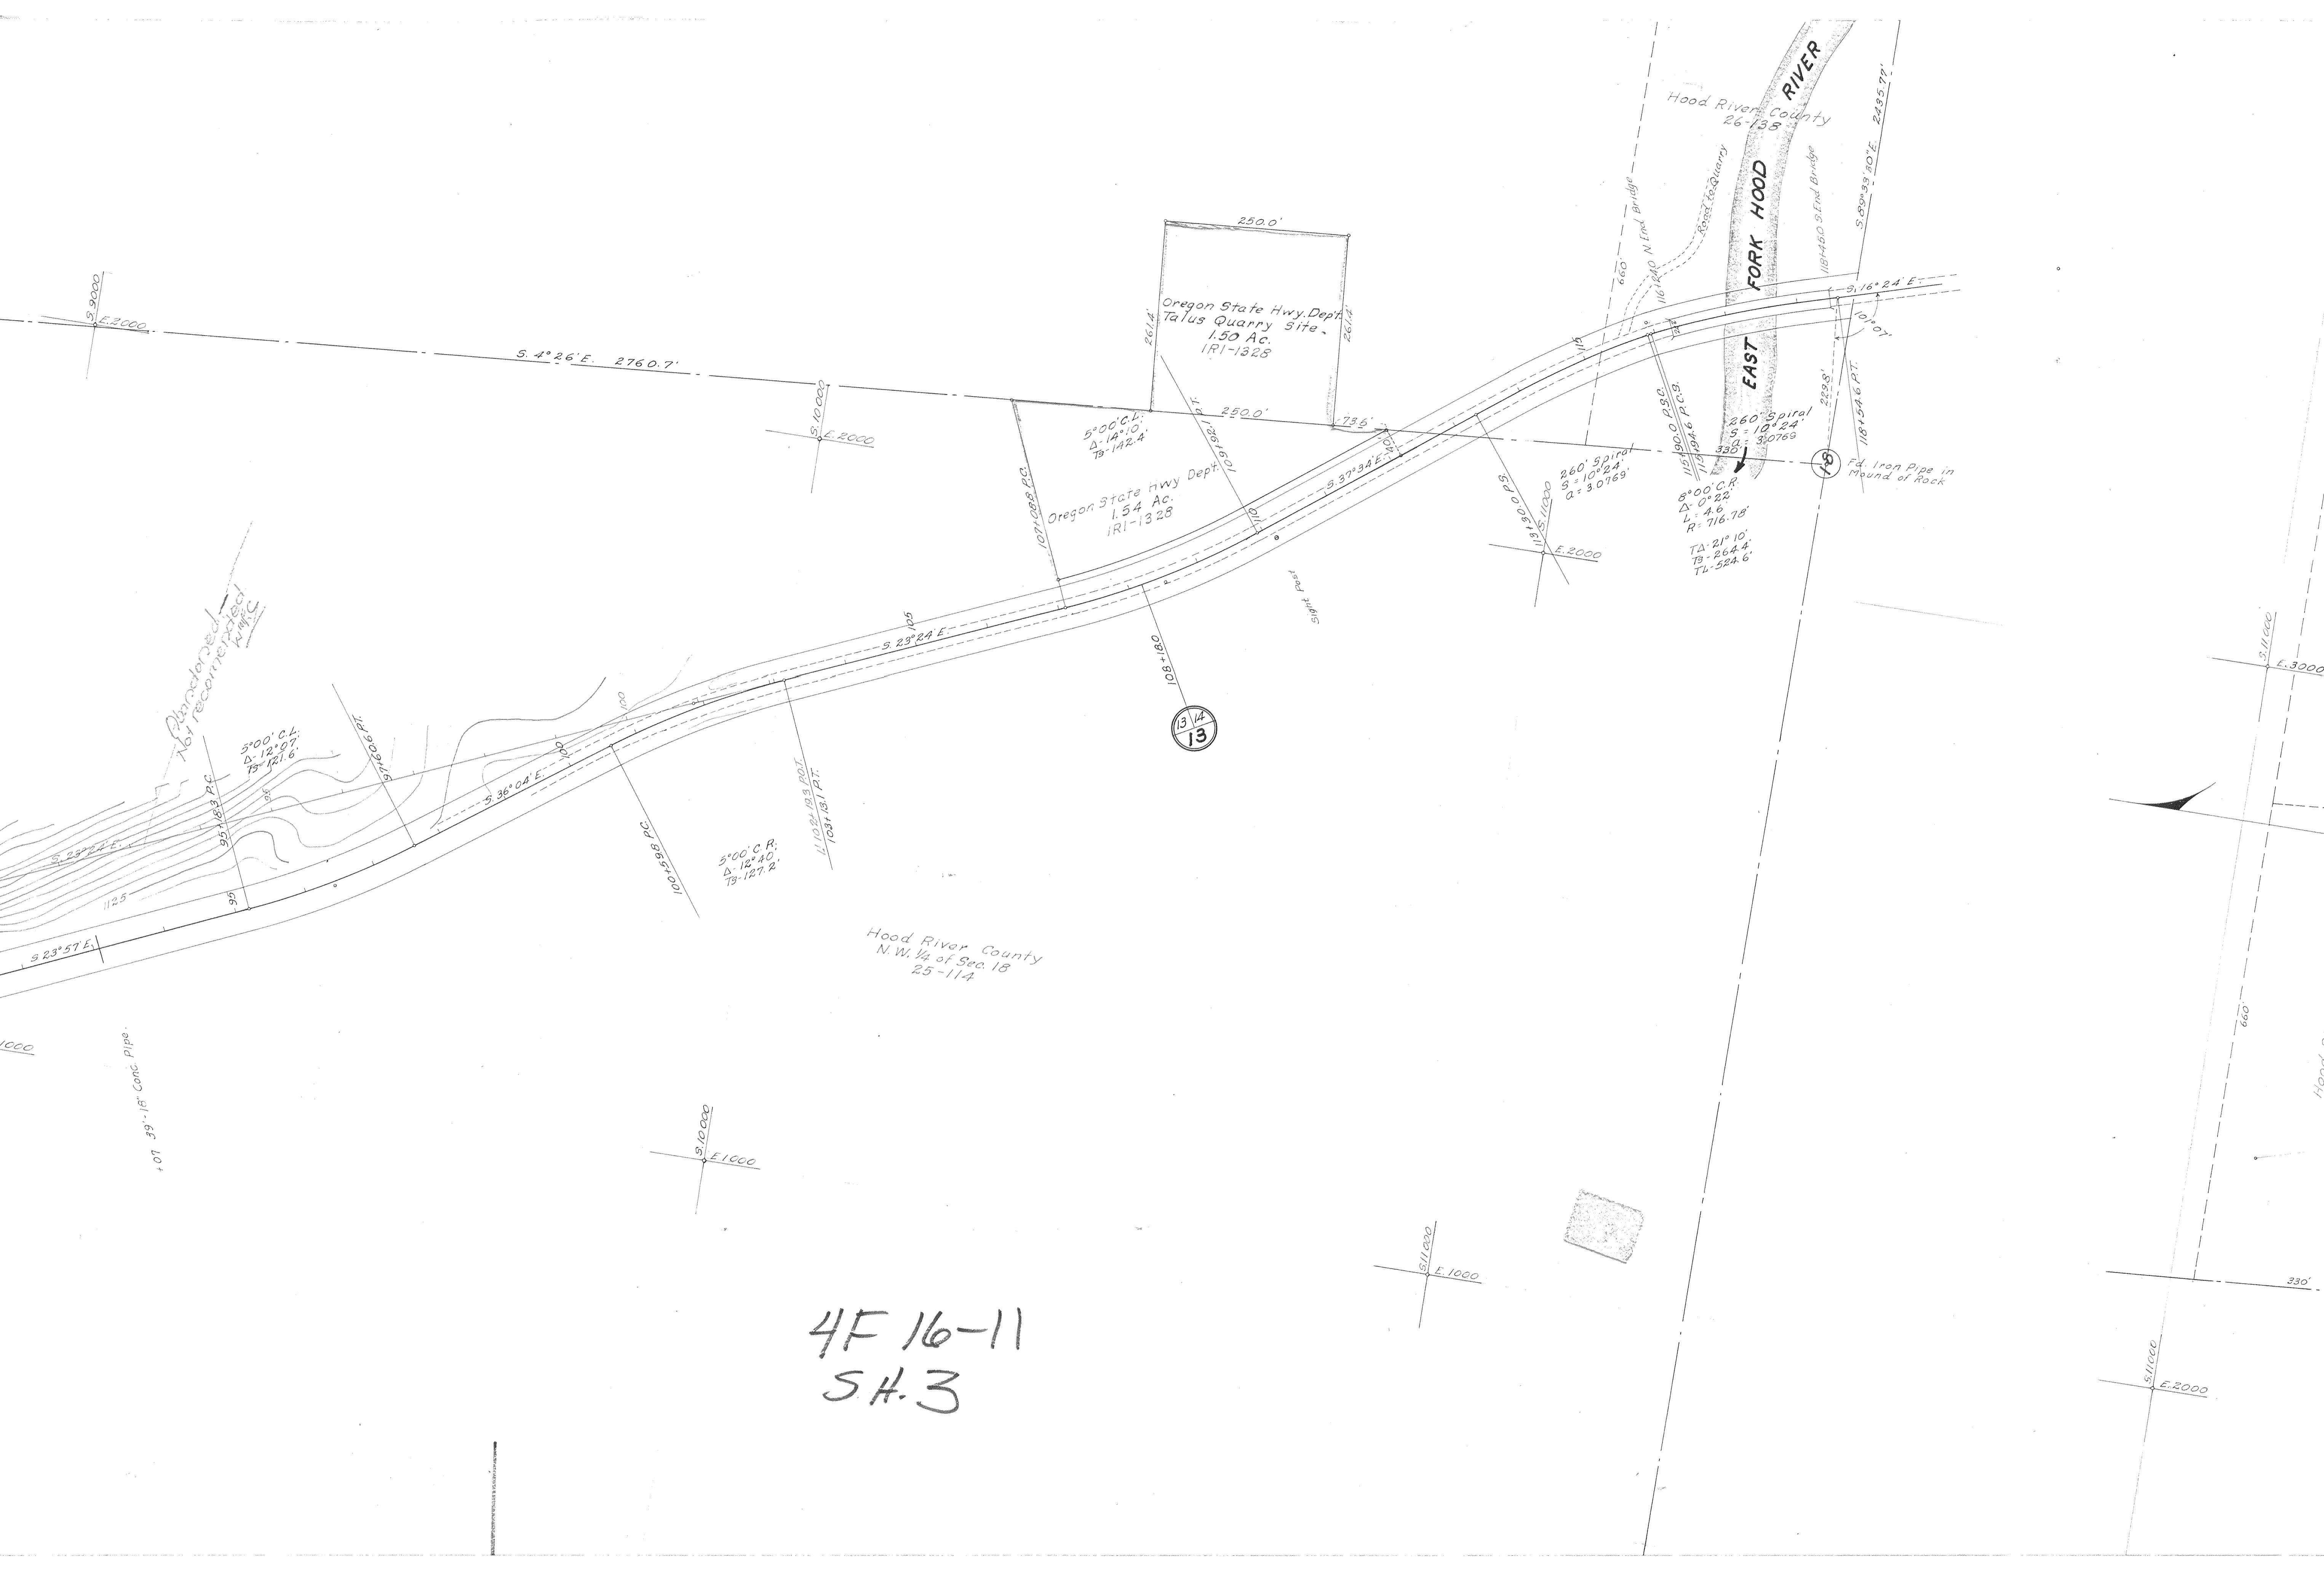

Oregon State Hwy Dept.
Talus Quarry Site.
1.50 Ac.
IRI-1328

Oregon State Hwy Dept.
1.54 Ac.
IRI-1328

Hood River County
N.W. 1/4 of Sec. 18
25-11A

Hood River County
26-133

EAST

260' Spiral
S = 10° 24'
L = 338'
a = 30769

8° 00' C.R.
Δ = 0° 22'
L = 4.6
R = 716.78

TΔ = 21° 10'
TΔ = 264.4
TL = 524.6


Fd. Iron Pipe in
Mound of Rock

4F 16-11
S.H. 3



Hood River County

Rock Quarry

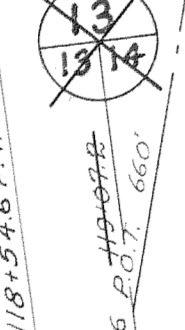

MT HOOD R.R. (Parkdale Branch)
Trout Creek

End of No Grading Section

George H. Thomas
N.W. 1/4 of S.E. 1/4 + N.E. 1/4 of S.W. 1/4 Sec. 18
24-326

O.J. Severson
20-581

4F16-11
SH. 4

(S. 89° 33' 1/2" E. 2435.77')
(1217.85')

8° 00' C.L.
Δ: 24° 27'
S: 155.2'

10° 00' C.R.
Δ: 42° 17'
S: 221.6'

2° 00' C.L.
Δ: 8° 29'
S: 212.5'

S. 11000
E. 3000

S. 11000
E. 2000

S. 12000
E. 2000

S. 15000
E. 4000

S. 13000
E. 3000

(S. 6° 57' 30" E.) (2647.9')

Hood River County
26-188

18'

18

19

2009.47' to Sec. Cor. 17-18-19-20 Fd Iron Bolt

690' to Base of Cliff
330'

118° 51.2' P.O.S.T.
118° 54.6' P.T.
118° 28.6' P.O.S.T.
118° 28.6' P.O.S.T.
660'

120° 05.0' P.C.
120° 40.0' P.O.S.T.

3° 40' 00" P.O.S.T.
E. 3000

134° 00.8' P.O.S.T.
528.0'

136° 24.9' P.C.

141° 09.1' P.T.

4.00 48"-18" Conc. Pipe

4.50 48"-18" Conc. Pipe

12" 6.4" Pipe-30'

140.100

140.100

1200'

1225'

542.59'

141409.1' P.T.

1200'

141409.1' P.O.S.T.

141409.1' P.O.S.T.

(S. 88° 29' E.)

remain Existing 7W

IP 8 Post

IP 8 Post

17-18-19-20 Rd Iron Bolt

S 14000
E 4000
(S 88° 05' E) (1233.4')

S 14000
E 4000

S 14000
E 4000

Fred + Lottie Maurer
South 1/2 of S.E. 1/4 of N.E. 1/4 Sec. 19
26-287 + 28-10
Sold on Contract to Ted Lowe

ON R/W to be Abandoned

(1333.35')

14
14.15

(S 2° 19' W) (2666.7')

To Parkdale

2° 00' C.L.
Δ 14° 50'
Σ 373.0'

14
14.15

S 7° 03' E

S 14000
E 3000

+00 38" 18" Conc. Pipe.

Hood River County
N.W. 1/4 of N.E. 1/4 Sec. 19
25-120
Sold on Contract to Grace I. Wright

S 15000
E 3000


Hood River County
N. 1/2 of S.W. 1/4 of N.E. 1/4 Sec. 19
23-326
Sold on Contract to Grace I. Wright


S 14000
E 3000

Hood River County
S. 1/2 of S.W. 1/4 of N.E. 1/4 Sec. 19
23-326
Sold on Contract to C.J. Hill et ux

18
19

(East)

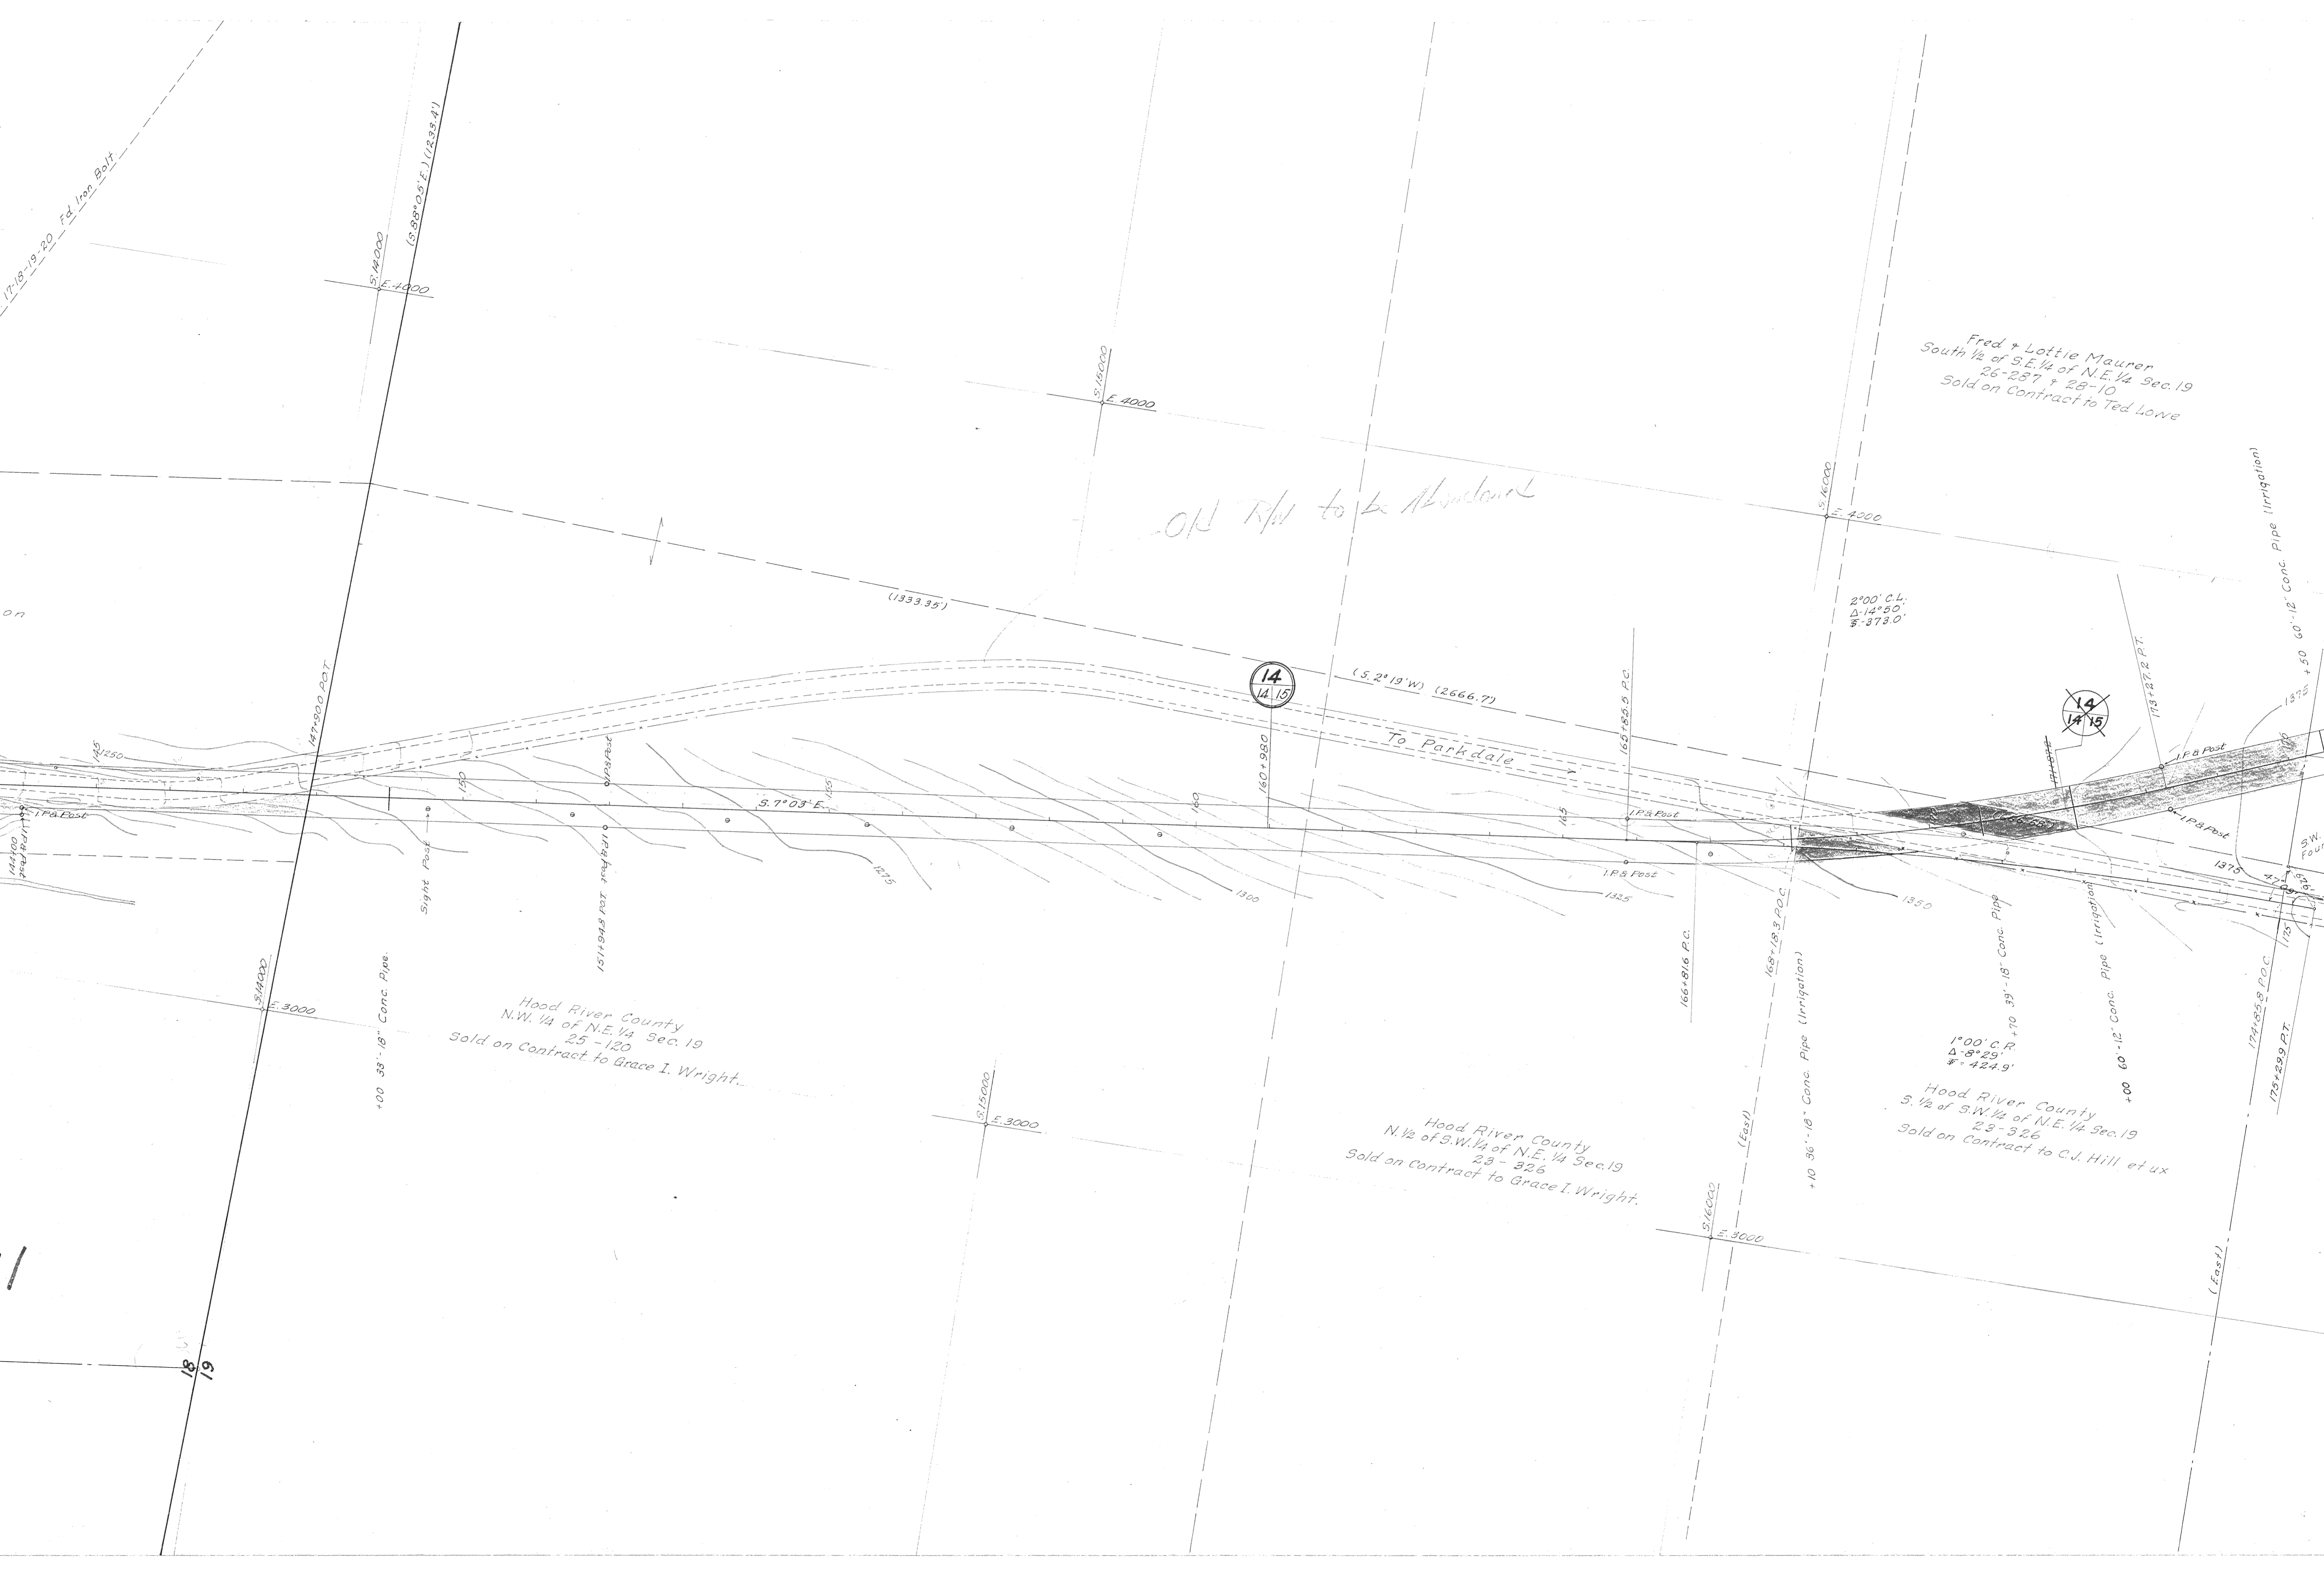

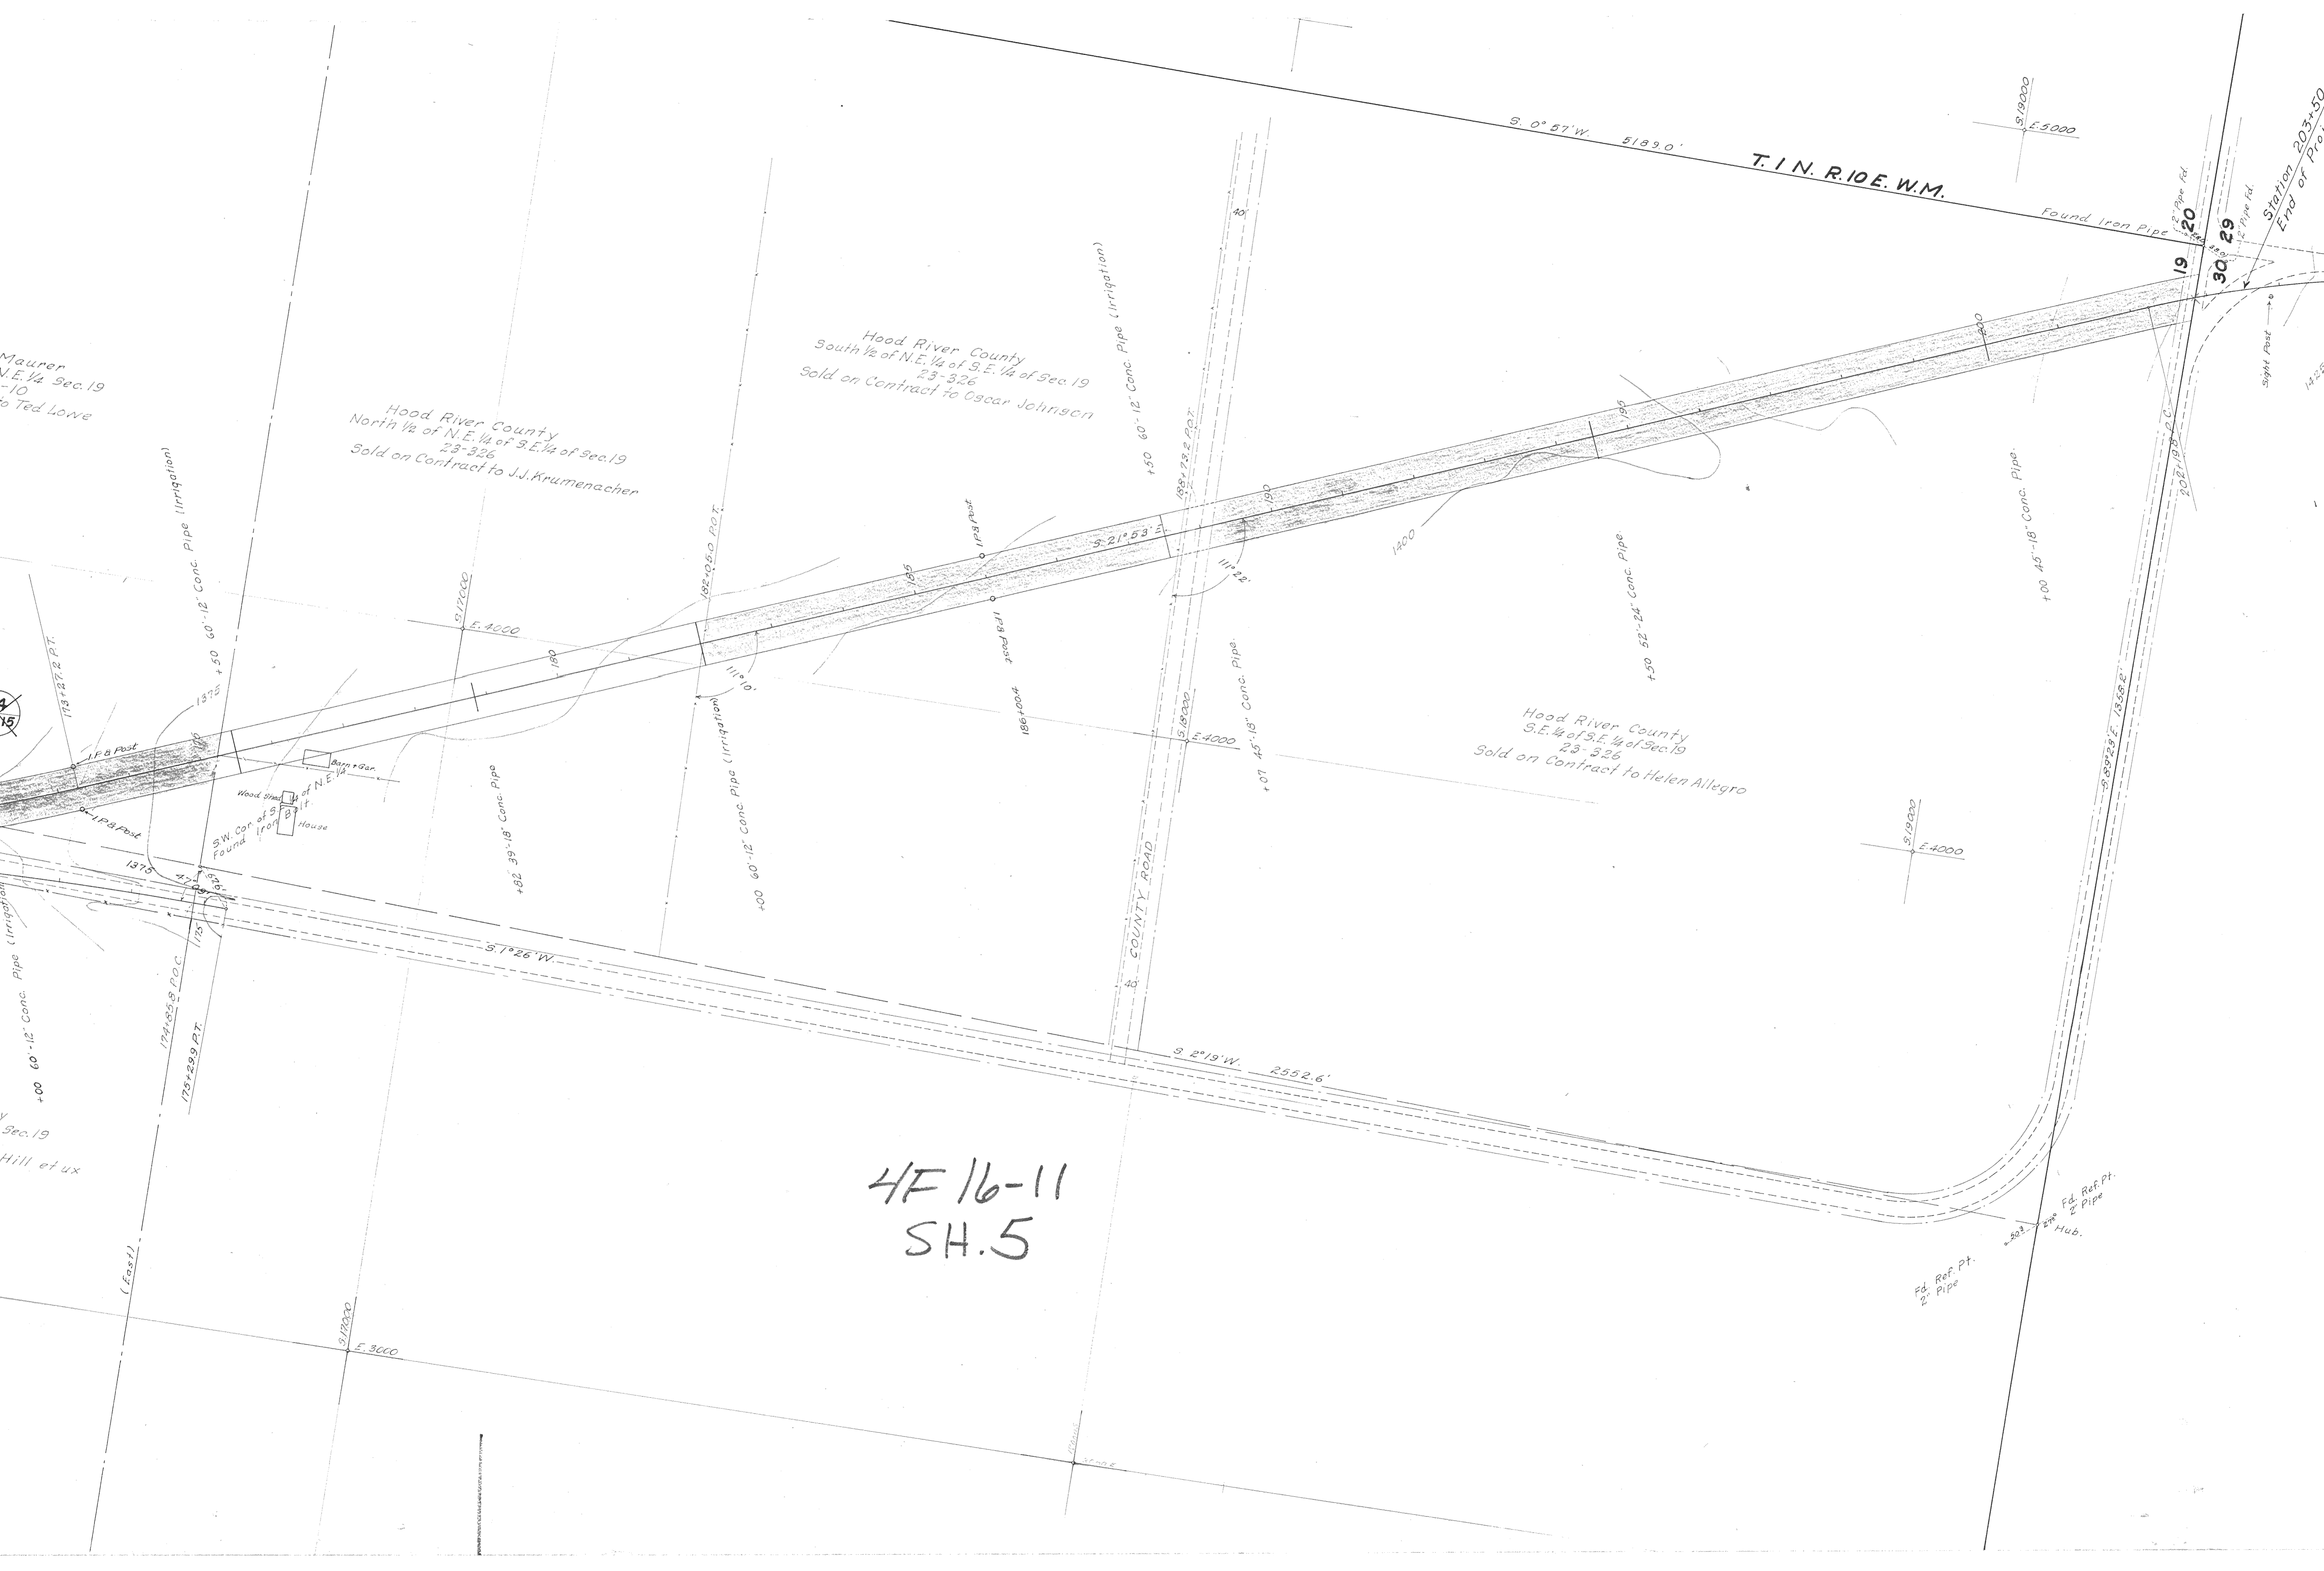



Station 203+50
End of Project

19+20
30+29

Iron Pipe
2" Pipe Fd.
2" Pipe Fd.

Sight Post →

14.25

20.5

4°00' C.R.
Δ - 21°52'
W - 276.7'

207+66.5 P.T.

R12+050 P.O.T.

50°01'E

S.20000
E.5000

S.20000
E.4000

ref. Pt.
ipe