

T. 2N., R. 11E., W. 1M
T. 2N., R. 10E., W. 1M

36
12
1


WHISKEY CREEK SECTION
MOUNT HOOD LOOP HIGHWAY
HOOD RIVER - PARKDALE SECTION

SCALE 1" = 100'

As Constructed Aug. 1953

5F 24-6
SH. 1

See 24-17-13

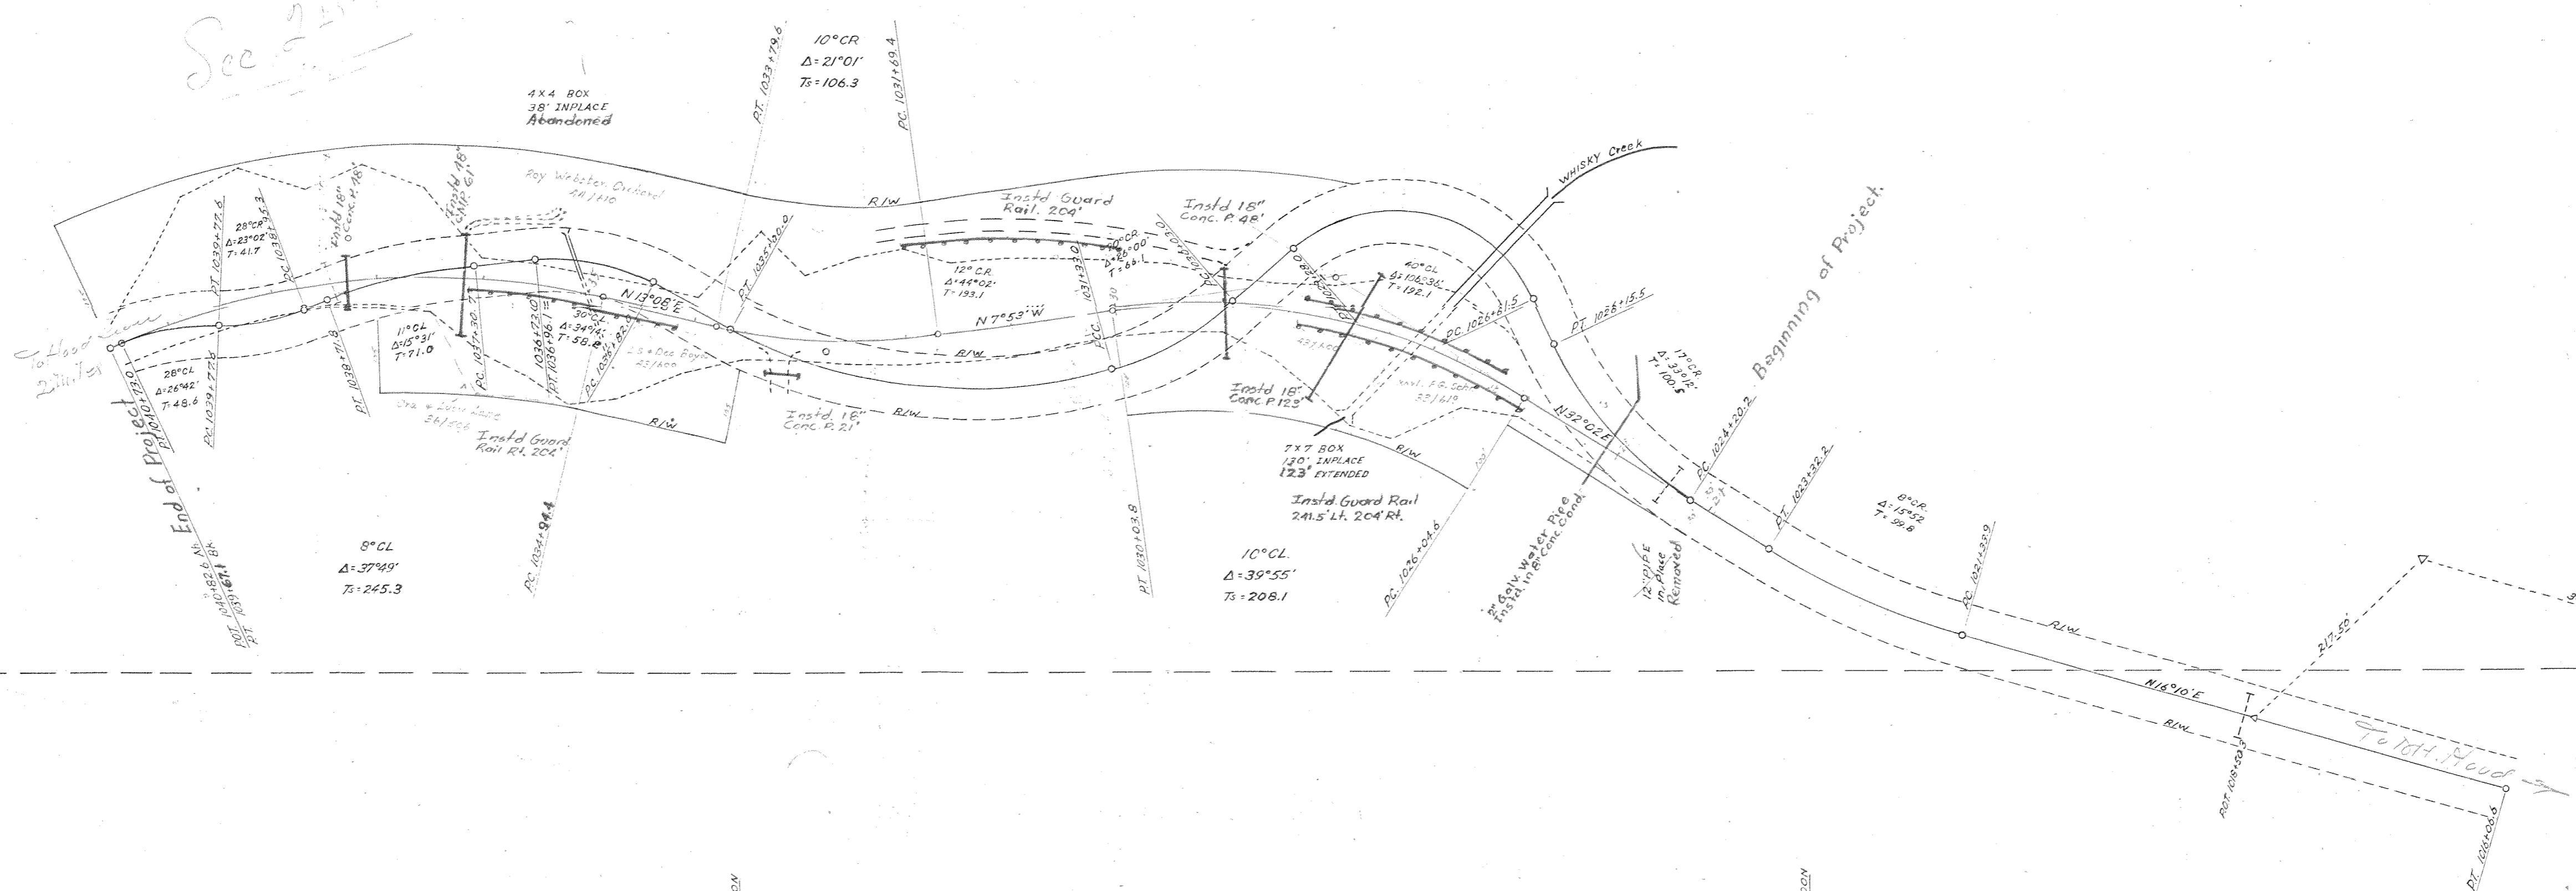

84000
48,000 F

84000
42,000 F

84000
47,000 F

84000
47,000 F