Lot Line Adjustment
City of Cascade Locks LLA 03-04
Hood River County, OR.

located in the NE1/4 SEC.12, T.2N. R.7E., W.M.

Survey Narrative and History

The purpose of this survey was to redefine the boundary line between adjusted tax lot 201 and 3700. The goal of adjusting tax lot 3700 was to encompass the existing house, giving street frontage.

existing house, giving street frontage.

The perimeter of the original tax lot 201 was first established for Robert Carroll in December 1975 by LS932, Hood River County Record Survey 7592. This survey found a 2" iron pipe and accepted it as the location of an iron bar referenced in Deed to Jesse Thompson (Hood River County Deed recorded December 1909, Book 3 page 523). An iron rod was set 27.6 feet north of the found pipe for the southwest corner of the Robert Carroll tract, also referenced as the southwest corner of the third tract of land described in deed to D.M. Haskins (Hood River County Deed recorded February 1930, Book 22 page 189). Hood River County Deed recorded February 1930, Book 22 page 189). Hood River County Deed recorded February 1930, Book 22 page 189). Hood River County Deed record Book 3 page 523, calls the bed of Atwell Creek North 321.6 feet from the Jesse Thompson iron bar. This fits the distance from the found iron pipe.

The third tract of land described in deed to D.M. Haskins calls the bed of Atwell Creek 294 feet north of an iron pipe. This distance fits from the iron rod set by LS932, 27.6 feet north of the 2" iron pipe to the bed of now, Dry Creek. In August 1983, LS1815 established the perimeter of the Carroll tract including tax lots 202 and 3700, Hood River County Survey Record 83061. This survey confirms the creek location as noted above. It also set corners along the east boundary and on the approximate northerly right—of—way of now Forest Lane, previously the Old Columbia River Highway..

In October 1990, LS932 partitioned the land to the west (PP9018, Hood River County Survey Record 90072). This survey set two more iron rods on the west line of this tract.

In October 1993, LS932 partitioned the land to the east (PP9335, Hood River County Survey Record 93096), recovering and accepting the monuments set by LS1815, Hood River County Survey Record 83061.

The northerly R/W of Forest Lane shown on this survey, was established using ODOT maps 3B-14-08m dated 1922 and 3B-24-17 dated 1935. Monuments were recovered at centerline stations 157+70 and 158+50 as shown on 3B-24-17. Bearings were rotated clockwise 5°59'30" with tangent distance between stations 162+80.1 and 165+30.1 shortened by 7 feet for best fit to existing roadway.

These surveys and found monuments were used to define the boundaries of the deed parcels prior to redefining the configuration of the adjusted tax lots. Tax lot 201 shown here is the adjusted tract following City of Cascade Locks Planning Action LLA 03-03 which adjusted the boundary between tax lots 201 and 202.

REFERENCES:

Record Survey 7368, LS932 Jan.1974

Record Survey 7592, LS932 Dec.1975 Record Survey 83061, LS1815 Aug.1983

Record Survey 90072 (PP9018), LS932 Oct.1990 Record Survey 93096 (PP9335), LS932 Oct.1993

Microfilm file no. 20024158, Aug.2002 Microfilm file no. 941670, June 1994

Microfilm file no. 893310, Dec.1989 Microfilm file no. 751438, July 1975 Microfilm file no. Bk3 P523, Dec.1909


Microfilm file no. Bk2 P188, Feb.1930 Microfilm file no. Bk39 P464, Jan.1949

Survey for Jeff and Claudia Jones 345 Forest Lane Cascade Locks. Oregon PROFESSIONAL LAND SURVEYOR

OREGON
July 21, 1998
ROBERTA D. ROMIO
2878

Expires 12/31/2004

Tanglewood Surveying 525 Sleepy Hollow Rd. Appleton, WA. 98602 509-365-5256 E-mail: tanglewood@gorge.net March 2004

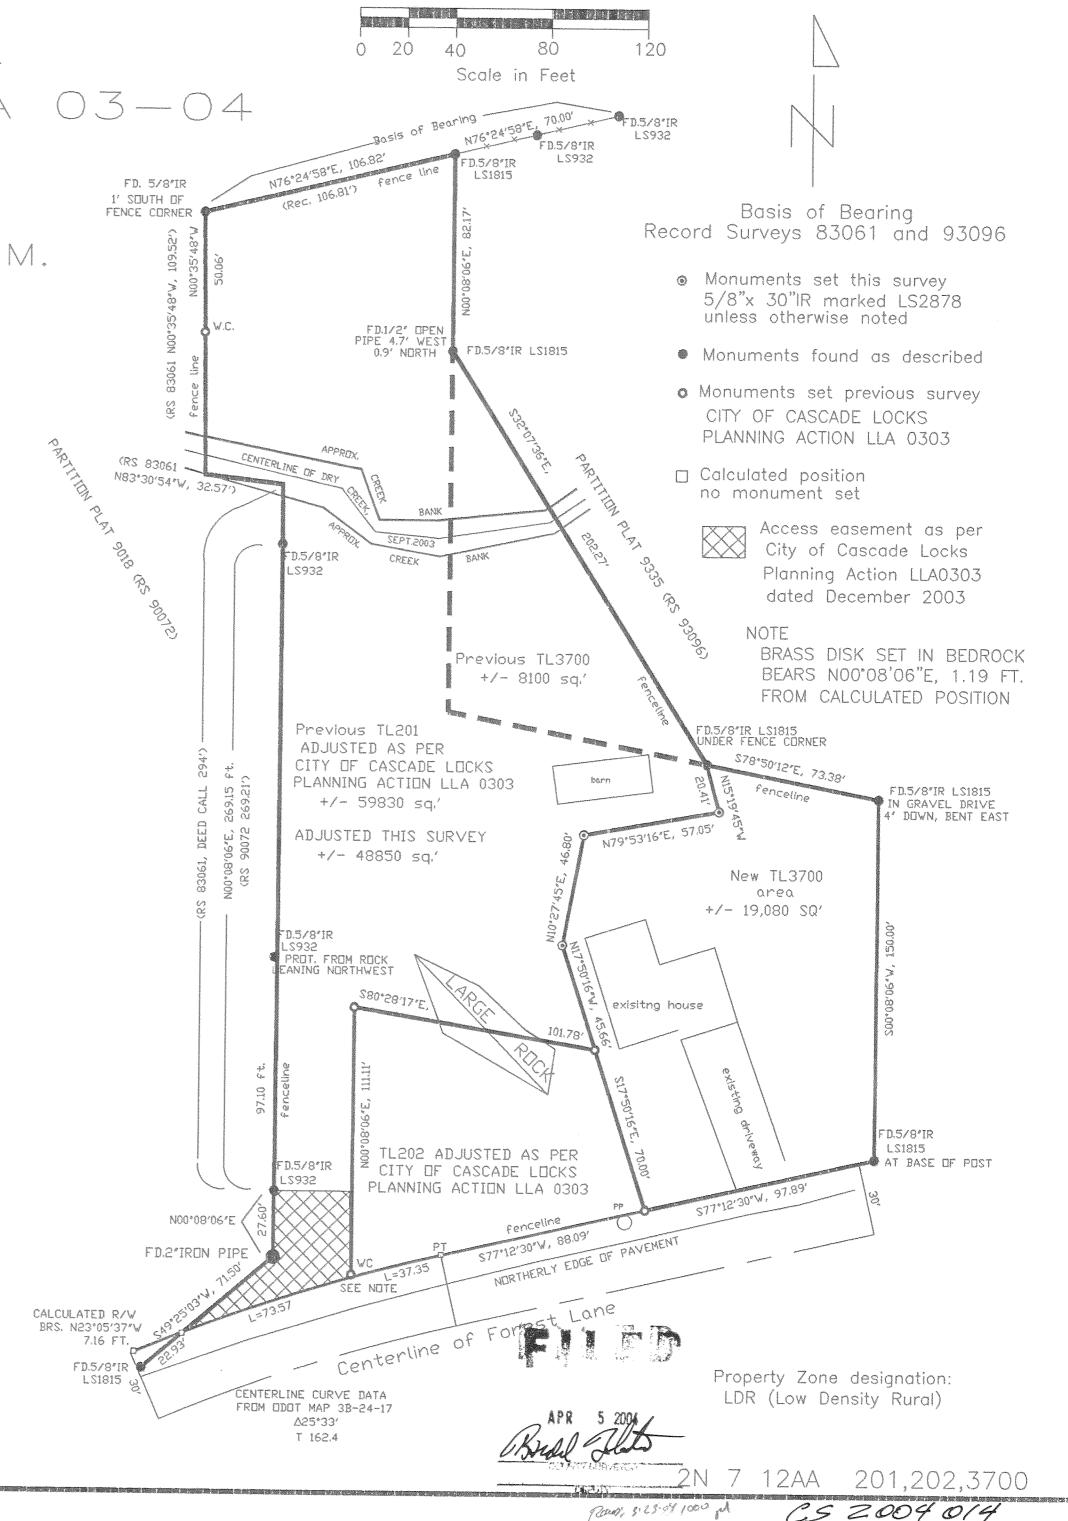

).