


SECTION 4 T.1S. R.10E. WM.
HOOD RIVER COUNTY

IS 10 4

1" = 400'

SEE MAP IN 10

1491

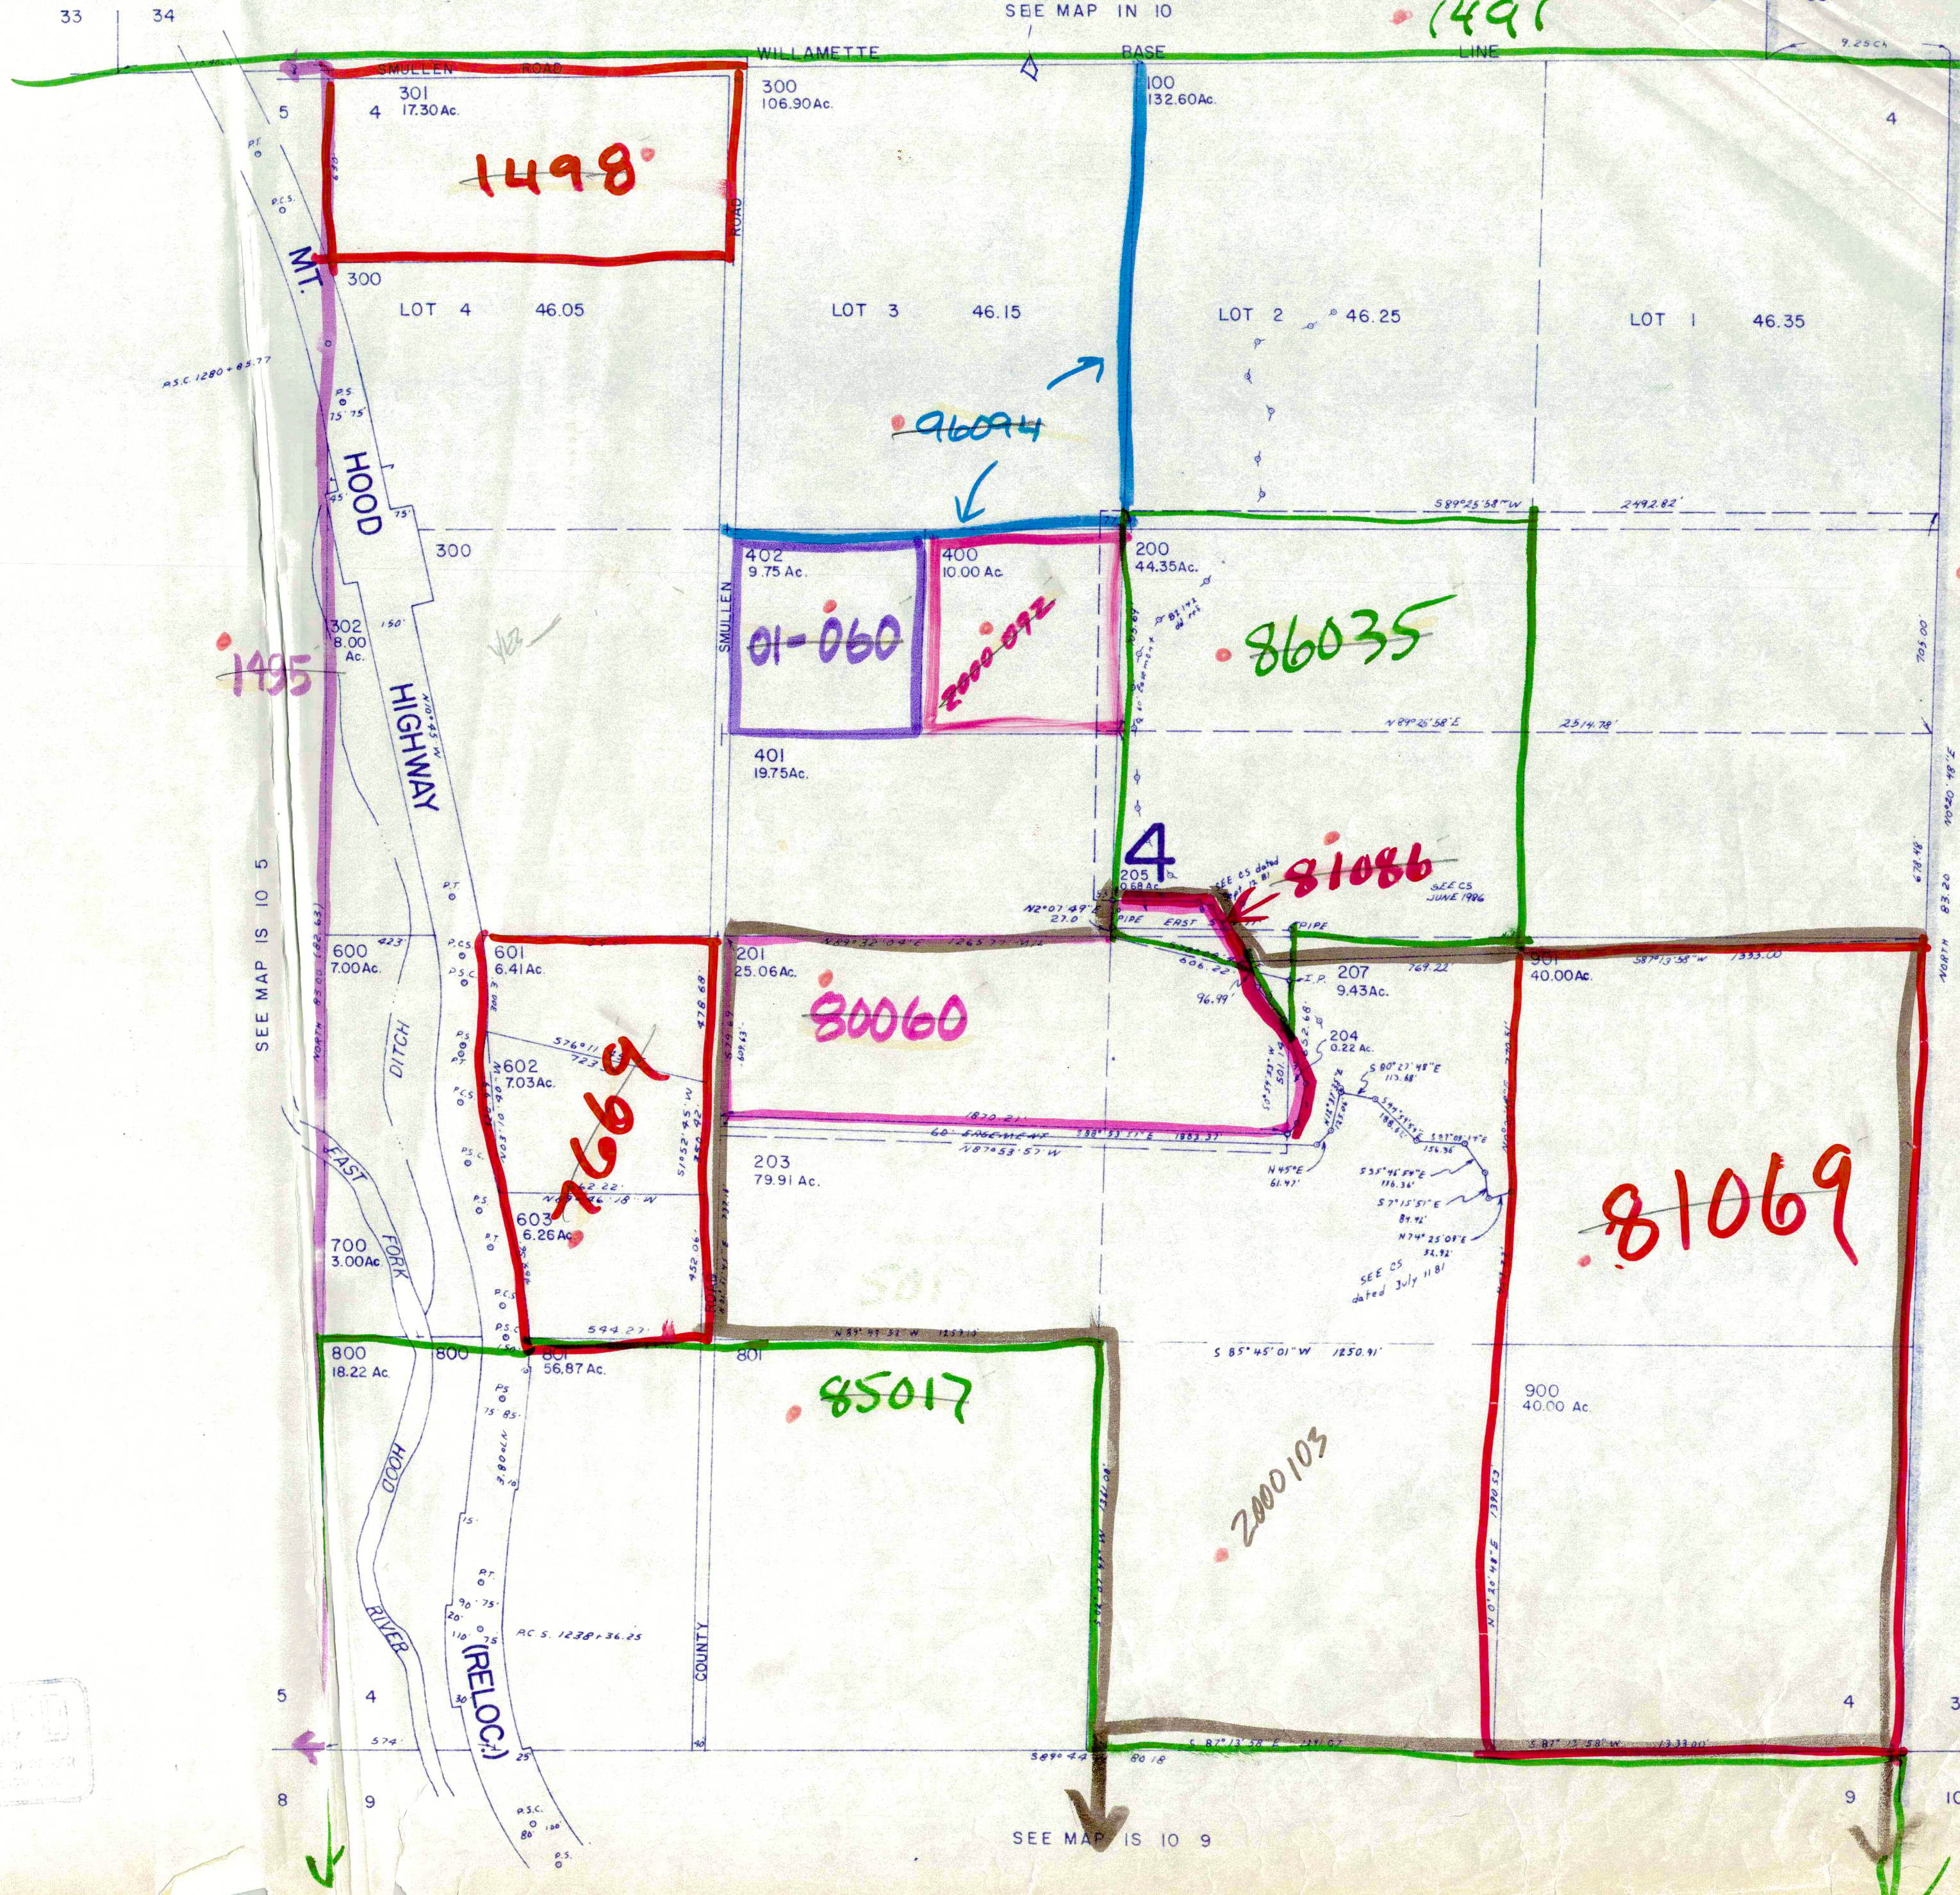

CANCELLED NO'S
202
500
206

Entire Section
~~8248~~
~~0249~~
1497
7584
1491
96094

SEE MAP IS 10

1. S 45° 00' 00" W 40.00'
2. S 12° 37' 39" W 130.92'
3. S 18° 44' 59" E 161.75'
4. S 18° 44' 59" E 49.61'
5. N 40° 04' 21" W 158.20'
6. N 30° 34' 49" W 122.30'
7. N 30° 34' 49" W 82.76'
8. N 68° 53' 34" W 45.81'
9. N 90° 00' 00" W 185.00'
10. N 02° 07' 48" E 82.04'

IS 10 4

