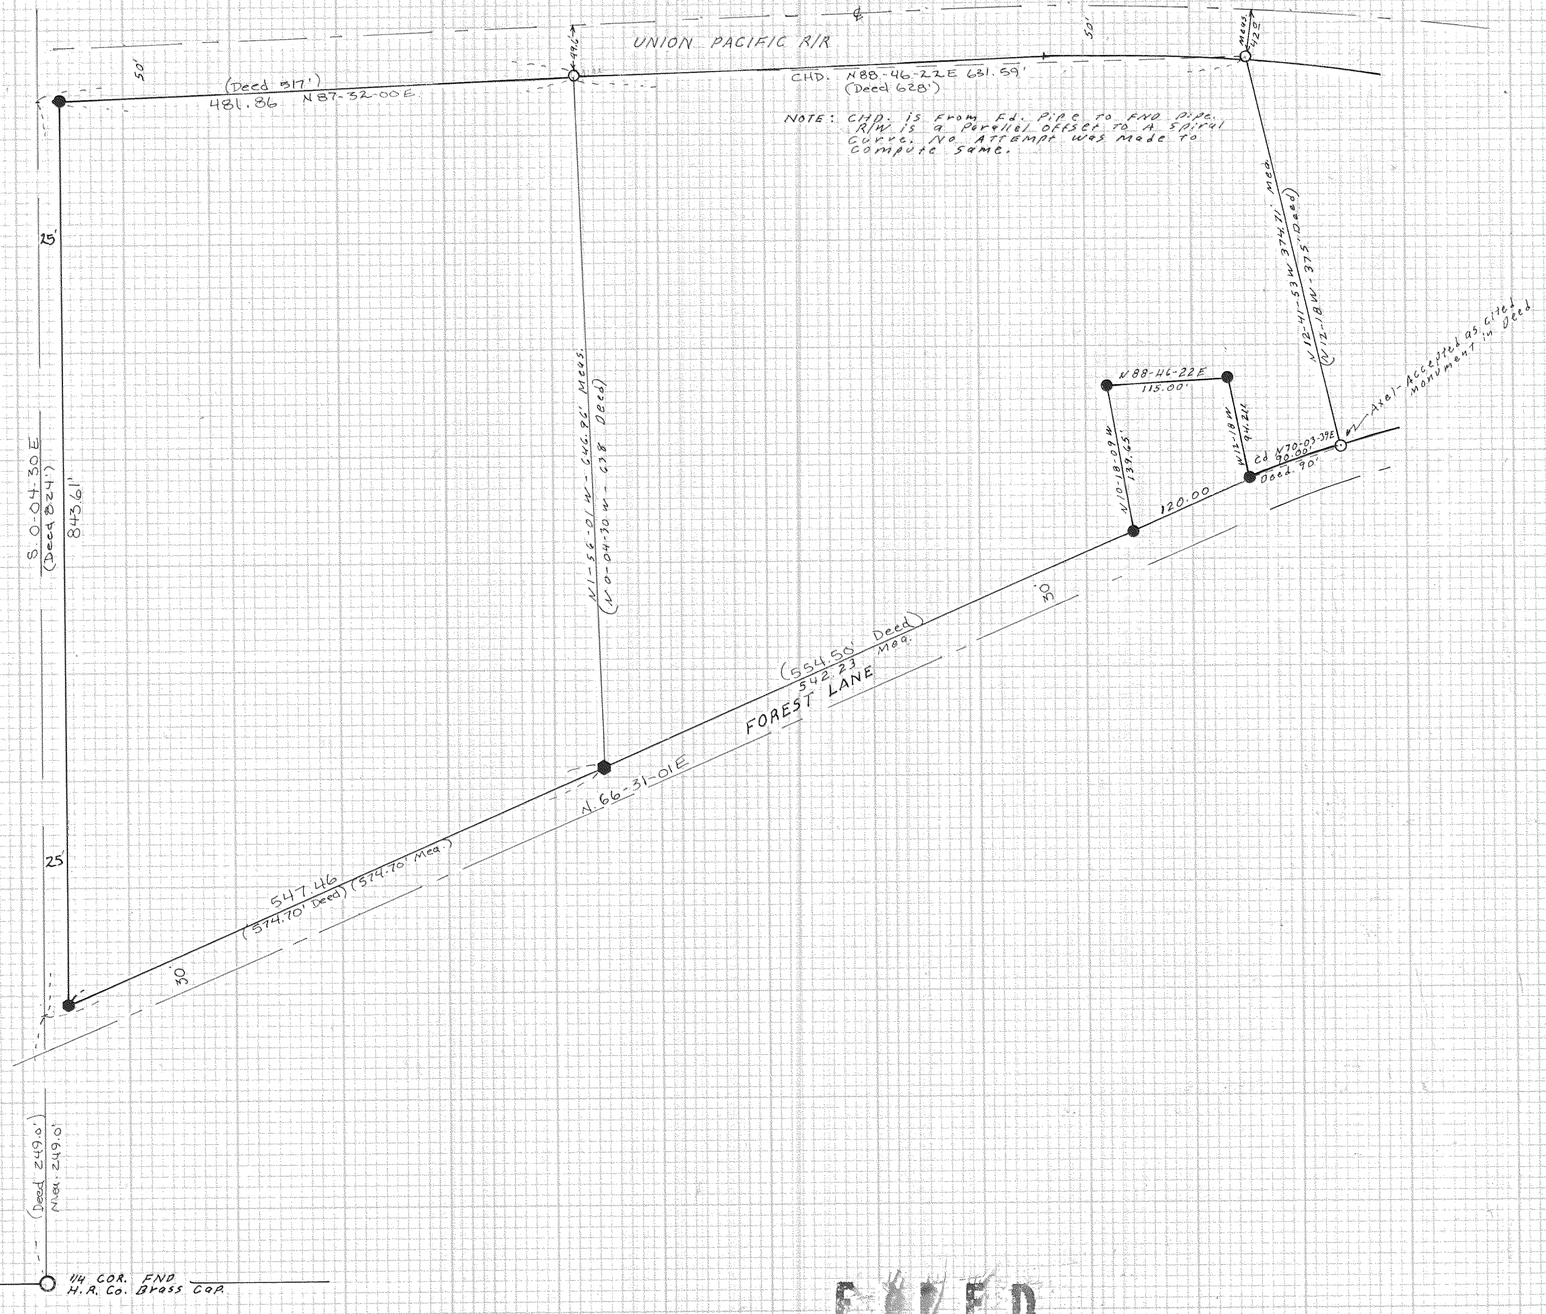

SURVEY for

S.M. BURGESS

REGISTERED PROFESSIONAL LAND SURVEYOR

Larry D. Bishop

OREGON
LARRY D. BISHOP
696

FILED
MAR 13 1981
COUNTY SURVEYOR
By
DEPUTY

NARRATIVE

LOCATION - SW1/4 SE1/4 Sec. 6, T. 2 N., R. 8 E., W.M.

○ FND. IRON PIPE - ACCEPTED AS PIPES CITED IN DEED

● SET R/R SPIKE

● SET 5/8" x 30" IRON ROD

CONTROLING ELEMENTS: PIPES AS NOTED - DEED DISTANCE ON HWY - N/S ℄ FROM PREVIOUS SURVEYS FOREST LANE AS BUILT - DEED BRNG. E. LINE .31 Ac. PARCEL

INSTRUMENT: TOPCON "GUPPY"

BASIS of BEARING - BONNEVILLE LANDS MAP - 1935

DATE: MAR. 3, 1981

SCALE: 1" = 100'

BISHOP SURVEYING, INC.

#8 4th ST. - P.O. BOX 729

HOOD RIVER, ORE. 97031

PROJECT # 80065

81027