#860066

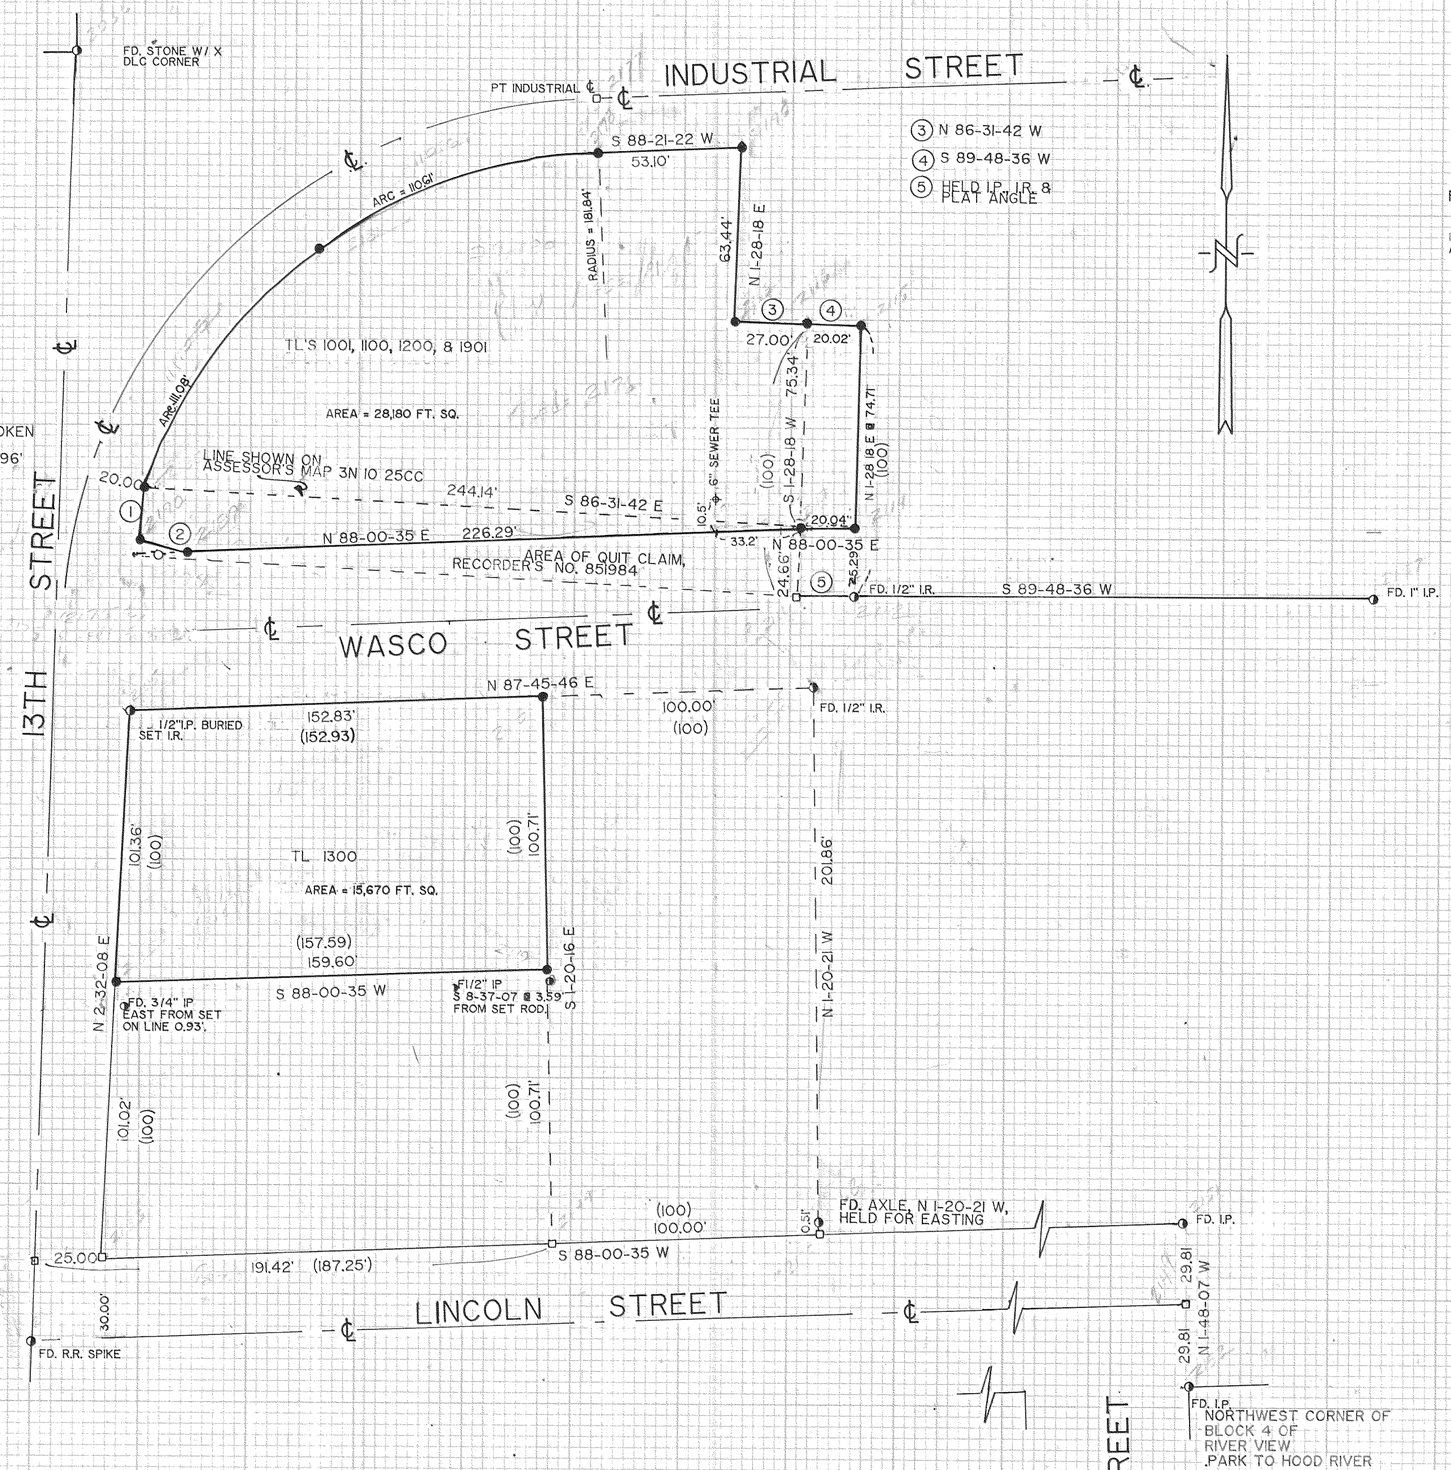

NARRATIVE

IRON RODS & PIPES SHOWN IN THE NEWLY CONSTRUCTED STREETS, ETC. WERE LOCATED BY TERRA SURVEYING BEFORE THEY WERE DESTROYED. NO MAJOR DISCREPANCIES WERE FOUND BETWEEN DEED CALLS AND SURVEY MEASUREMENTS.

THE COUNTY TAX MAP DOES NOT CORRECTLY REPRESENT DEED DESCRIPTION 851984.

INDUSTRIAL STREET CURVE DATA WAS FROM THE CITY ASBUILT PLANS.

LOCATION OF SURVEY:

TL's 1001, 1100, 1200 & 1300 of 3N 10 25CC in the CITY of HOOD RIVER, HOOD RIVER COUNTY OREGON.

BASIS OF BEARING:

TERRA SURVEYING #8546

REFERENCES

TERRA SURVEYING #8546

LEGEND

- ● SET 5/8" X 30" IRON ROD W/ CAP
- □ CALCULATED, NOT FOUND OR SET
- ◑ FOUND MONUMENT AS NOTED
- ( ) DEED CALL

SURVEY
for
JOE YOUNG
HOOD RIVER, OR.

REGISTERED PROFESSIONAL LAND SURVEYOR
OREGON
JULY 13, 1979
ROY O. GAYLORD
1818

TERRA SURVEYING
DATE: NOVEMBER, 1986
SCALE: 1"=40'
PROJECT: 8642
P.O. BOX 617
HOOD RIVER, OR. 97031
PHONE (503) 386-4531

FILED
DEC 5 1986
Richard G. Aunt
COUNTY SURVEYOR
DEPUTY

#860066